IREDELL COUNTY HEALTH DEPARTMENT

STATESVILLE 704-878-5305 MOORESVILLE 704-664-5281

IMPROVEMENT PERMIT / AUTHORIZATION TO CONSTRUCT / OPERATION PERMIT / EXISTING SYSTEM INSPECTION

PERMIT# 089293 PIN# 4713632148 (pt) DATE Jan 25, 01

OWNER OR CONTRACTOR Earl Garrick PHONE: Business 374-9700 Home

ADDRESS 9815 J Sam Furr Rd. Huntersville, NC 28078

LOCATION From Trantham Rd/Old Rock TL Angel Oaks DRIVE on Left

SUBDIVISION Angel Oaks BLOCK / SECTION LOT 10 LOT AREA .55 Ac SITE CLASS PS DESIGN FLOW 360 gpd L.T.A.R. .025-.03

Septic Tank: 1000 Gallons: STB 1012 Date 07/09/02
Pump Tank: Gallons: PT Date
Pump Make: Model Serial No.
Nitrification Field: No Fields 1 Square Feet 1050 Linear Feet 350
No Lines 5 Trench Width 36" Trench Bottom Depth 36"

☑ New System ☐ Repair System Type: I. II. III. IV. V. VI
System Description: Gravity Innovative -25% Reduction
Repair System Description: Gravity/LP Innovative
Maintenance Agreement Required: ☐ Yes ☑ No
Gravel Depth N/A ☐ Slab ☑ Crawl Space ☐ Basement w/plumbing ☐ Basement wo/plumbing

☑ House/Mod. Home No. Bedrooms 3
☐ Mobile Home No. Bathrooms 2
☐ Business No. Employees
☐ Other


Water Supply: ☐ Individual ☑ Public ☐ Community

Comments/Conditions: Install Laterals as close to 36" trench bottom as possible

Comments/Conditions: SEPTIC TANK INSTALLED USING TUFF-TIGHT FILTER & SEPTIC MARKER.

1"=50'

INITIAL SITE SKETCH

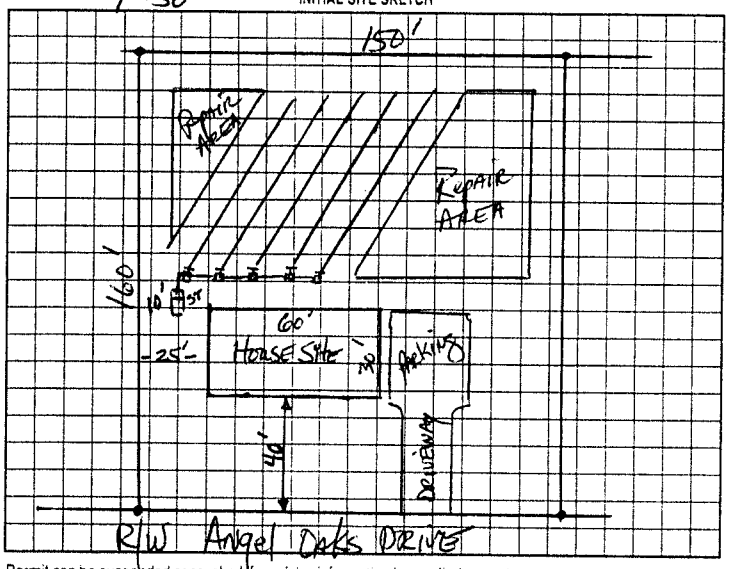

AS BUILT SKETCH

* SYSTEM INSTALLED AS SHOWN IN INITIAL SITE SKETCH.

Permit can be suspended or revoked if any false information is supplied toward securing the permit/any unauthorized changes are made to the site/any unauthorized changes are made in the installation of the system. Improvement Permit with plat valid without expiration. Improvement Permit with site plan valid for sixty months. Authorization to Construct is valid for a period equal to that of Improvement Permit – not to exceed sixty months.

Signed: date

Improvement Permit by: date 1-25-01

Authorization to Construct by: date 09/19/02

Installed by: A-1 BACKHOE

Operation Permit by: Patrick Mitchell date 11/14/02

Existing System Inspection by: date

HEALTH DEPT COPY WHITE OWNER COPY (FINAL) YELLOW OWNER COPY (INITIAL) PINK