IREDELL COUNTY HEALTH DEPARTMENT

STATESVILLE 704-878-5305 MOORESVILLE 704-664-5281

IMPROVEMENT PERMIT / AUTHORIZATION TO CONSTRUCT / OPERATION PERMIT / EXISTING SYSTEM INSPECTION

PERMIT# 089291 PIN# 4713632148(pt) DATE Jan 25,01

OWNER OR CONTRACTOR Earl Garrick PHONE: Business 374-9700 Home

ADDRESS 9815 J Sam Furr Rd. Huntersville

LOCATION From Treatman Old Nth Rd. TL Angel Oaks Drive on left

SUBDIVISION Angel Oaks BLOCK / SECTION LOT 8 LOT AREA .57 SITE CLASS. PS DESIGN FLOW 360gpd L.T.A.R. .25-.3

Septic Tank: 1000 Gallons: STB 1000 Date 11-8-02
Pump Tank: Gallons: PT Date
Pump Make: Model Serial No.
Nitrification Field: No Fields 1 Square Feet 1050 Linear Feet 350
No Lines 4 Trench Width 36" Trench Bottom Depth 36"

☑ New System ☐ Repair System Type: I. II. III. IV. V. VI.
System Description: Gravity Innovative-25% Red. LP Panel Block
Repair System Description:
Maintenance Agreement Required: ☐ Yes ☒ No 25% Red.
Gravel Depth NA ☐ Slab ☐ Crawl Space ☐ Basement w/plumbing ☐ Basement wo/plumbing


☑ House/Mod. Home No. Bedrooms 3
☐ Mobile Home No. Bathrooms 2
☐ Business No. Employees
☐ Other

Water Supply: ☐ Individual ☑ Public ☐ Community


Comments/Conditions: DO NOT cut or lower house site, Exit plumbing near existing grade. Install laterals as close to 36" trench bottom as possible. * Initial system should not require maintenance agreement; Repair system will.

Comments/Conditions: SEPTIC TANK WITH MARKER INSTALLED USING "POLYLOK" FILTER

INITIAL SITE SKETCH

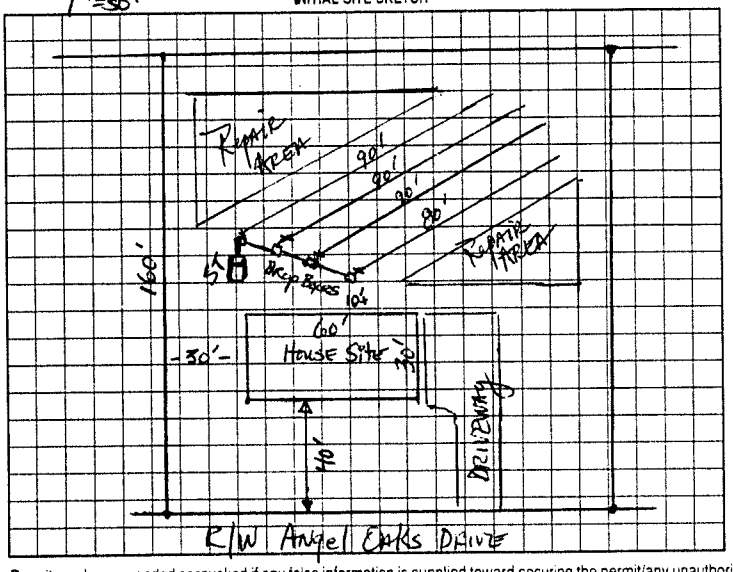

AS BUILT SKETCH

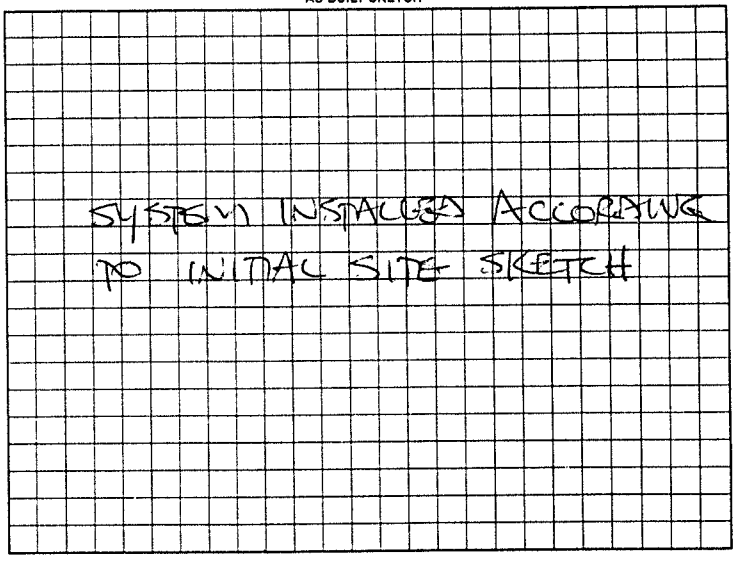

Permit can be suspended or revoked if any false information is supplied toward securing the permit/any unauthorized changes are made to the site/any unauthorized changes are made in the installation of the system. Improvement Permit with plat valid without expiration. Improvement Permit with site plan valid for sixty months. Authorization to Construct is valid for a period equal to that of Improvement Permit – not to exceed sixty months.

Signed: date

Improvement Permit by: date 1-25-01

Authorization to Construct by: date 1-9-02

Installed by: STATESVILLE BACKHOE

Operation Permit by: STEVE HENDRICK date 2-22-02

Existing System Inspection by: date

HEALTH DEPT. COPY WHITE OWNER COPY (FINAL) YELLOW OWNER COPY (INITIAL) PINK