IREDELL COUNTY HEALTH DEPARTMENT

STATESVILLE 704-878-5305 CI MOORESVILLE 704-664-5281

IMPROVEMENT PERMIT / AUTHORIZATION TO CONSTRUCT / OPERATION PERMIT / EXISTING SYSTEM INSPECTION

PERMIT# 115896 PIN# 4713-62-6958 DATE September 18, 03

OWNER OR CONTRACTOR Earl Garrick / Premier Developers PHONE: Business _____ Home _____

ADDRESS 9815 J. Sam Furr Road Suite 221 Huntersville, N.C. 28078

LOCATION From Troutman - old Nito Road TL Angel Oaks Drive 7th lot on left

SUBDIVISION Angel Oaks BLOCK / SECTION _____ LOT 7 LOT AREA .5 Ac SITE CLASS. PS DESIGN FLOW 360 gpd L.T.A.R. .025

Septic Tank: 1000 Gallons; STB 1007 Date 11-6-03

Pump Tank: _____ Gallons; PT _____ Date _____

Pump Make: _____ Model _____ Serial No. _____

Nitrification Field: No Fields 1 Square Feet 480 / 720 Linear Feet 240

No Lines 5 Trench Width 24" min 8'oc Trench Bottom Depth * 36" Gravel Depth NA

☑ New System ☐ Repair System Type: I, II, III, IV, V, VI

System Description: Gravity PPBPS

Repair System Description: LPP PPBPS

Maintenance Agreement Required: ☐ Yes ☑ No initially

☑ House/Mod. Home No. Bedrooms 3

☐ Mobile Home No. Bathrooms 2

☐ Business No. Employees ____

☐ Other _____

☐ Slab ☑ Crawl Space ☐ Basement w/plumbing ☐ Basement wo/plumbing

Water Supply: ☐ Individual ☑ Public ☐ Community

Comments:/Conditions: or 36" max 900

* Install Laterals at 36" trench bottom depth (minimum) to 42" maximum Trench bottom depth.

1"=50'


Comments:/Conditions: TUFFTITE FITTERS & MARKER

INSTALLED AS DRAWN


NEED TO ✓ sand when put in 3-4-04

✓ ID SAND OK 3-5-04

160' INITIAL SITE SKETCH

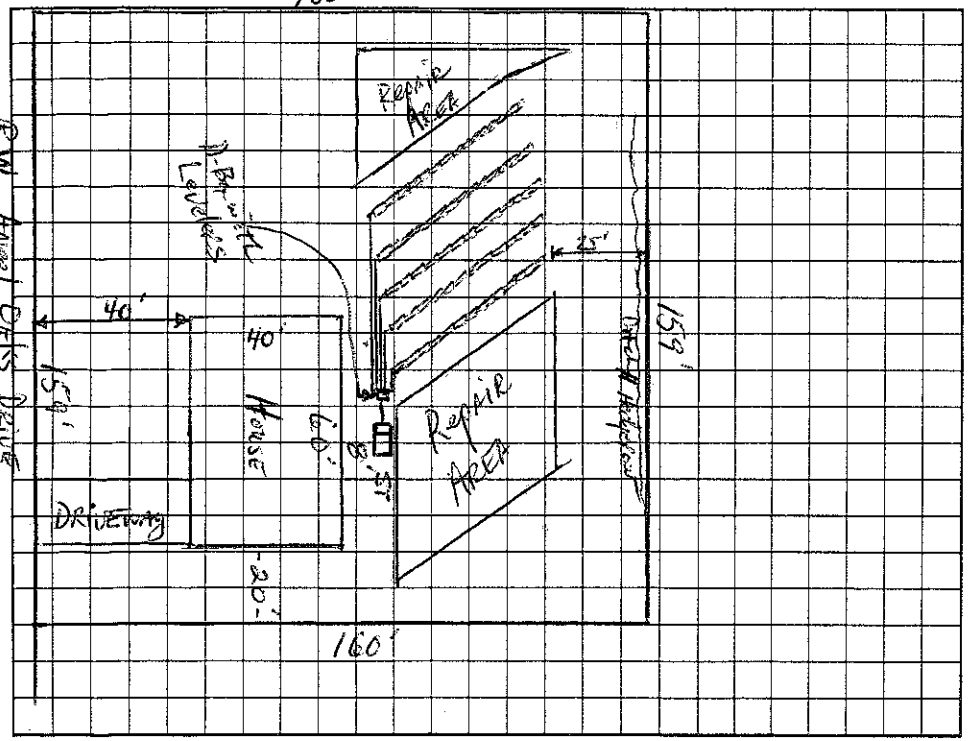

AS BUILT SKETCH

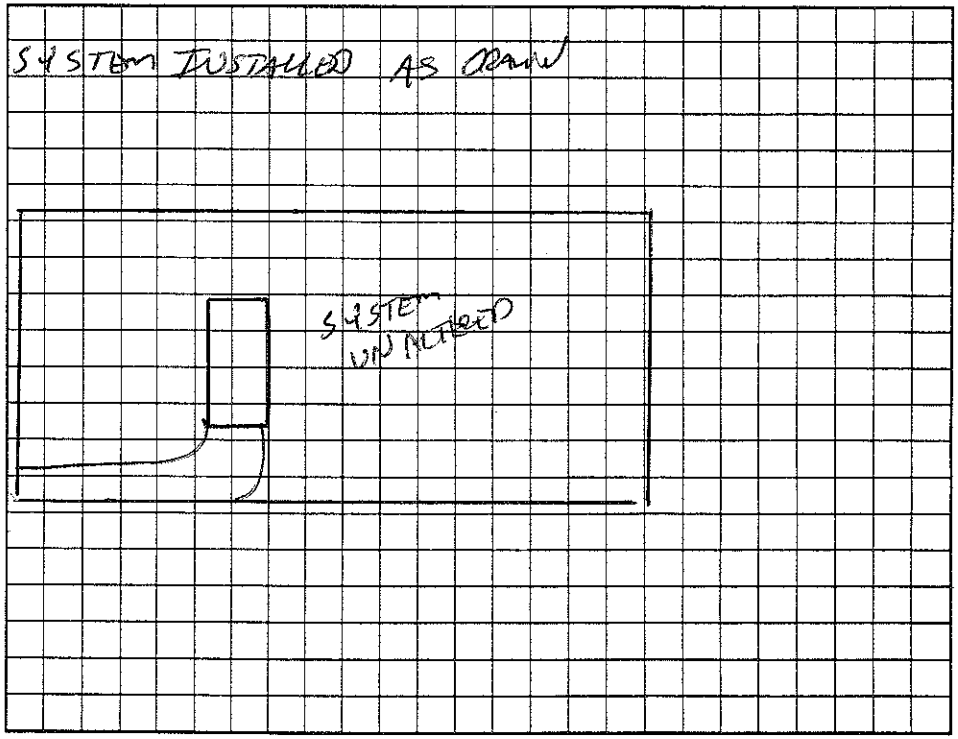

Permit can be suspended or revoked if any false information is supplied toward securing the permit/any unauthorized changes are made to the site/any unauthorized changes are made in the installation of the system. Improvement Permit with plat valid without expiration. Improvement Permit with site plan valid for sixty months. Authorization to Construct is valid for a period equal to that of Improvement Permit – not to exceed sixty months.

Signed Earl Garrick (9-19-03) date 9/20/03

Improvement Permit by: _____ date 9-18-03

Authorization to Construct by: _____ date 10-3-03

Installed by: DERRICK JENKINS

Operation Permit by: _____ date 3-5-04

Existing System Inspection by: _____ date _____

HEALTH DEPT. COPY: WHITE OWNER COPY (FINAL): YELLOW OWNER COPY (INITIAL): PINK