IREDELL COUNTY HEALTH DEPARTMENT

STATESVILLE 704-878-5305 MOORESVILLE 704-664-5281

IMPROVEMENT PERMIT / AUTHORIZATION TO CONSTRUCT / OPERATION PERMIT / EXISTING SYSTEM INSPECTION

CI

PERMIT# 138427 PIN# 4713630211 DATE 12-12-07

OWNER OR APPLICANT Premier Pavers Inc PHONE: Business 704-948-6466 Home

ADDRESS 9815 J Sam Furr Rd Suite 221 Huntersville NC 28078

LOCATION 21 South @ Cmr @ Angel Oaks @ Fallow Leaf @ Turnip Leaf at end on RT

SUBDIVISION Angel Oaks BLOCK / SECTION LOT 34 LOT AREA 1.75 + offsite SITE CLASS. PS DESIGN FLOW 360 L.T.A.R. .3

Septic Tank: 1000 Gallons: ST8 794 Date 3-7-07

Pump Tank: 1000 Gallons: PT 733 Date 3-19-07

Pump Make Wayne Model WE40SU1H Serial No.

Nitrification Field: No. Fields 1 Square Feet 562=1260 Linear Feet 300 1

No. Lines 5 x 60' Trench Width 36" Max Trench Bottom Depth 36"

☒ New System ☐ Repair ☐ Expansion System Type: I II III IV V VI

System Description: Pump 25% Reduct

Repair System Description: LP 50%, Reduct

Maintenance Agreement Required: ☐ Yes ☒ No

Gravel Depth N/A ☐ Gravity ☒ Pressure ☐ Slab ☒ Crawl Space ☐ Basement w/plumbing ☐ Basement wo/plumbing

☒ House/Mod. Home ☐ Mobile Home ☐ Business ☐ Other

No. Bedrooms 3 No. Persons 6 No. Employees

Water Supply: ☐ Individual ☒ Public ☐ Community

Comments/Conditions: ① EROSION CONTROL DITCH & SILT POND TO BE FILLED IN ONCE DRAINFIELD IS INSTALLED. AREA MUST BE SEEDED & BLANKED IMMEDIATELY AFTERWARDS, ② STAY 15'+ OFF DRAINFIELD WHEN FILL & GRADE WHEN

INITIAL SITE SKETCH

SEE ATTACHED SYSTEM DESIGN BY LOWE COOK, P.S.

Comments/Conditions: DONE TO PREVENT EROSION.

Pull Filter & Manifold

ST TANK 12' OFF R/W

As Needs Blue Permission to change tanks

Doug Walters

AS BUILT SKETCH

Permit can be suspended or revoked if any false information is supplied toward securing the permit/any unauthorized changes are made to the site/any unauthorized changes are made in the installation of the system. Improvement Permit with plat valid without expiration ☐ Improvement Permit with site plan valid for sixty months ☒ Authorization to Construct is valid for a period equal to that of Improvement Permit – not to exceed sixty months.

Signed: [signature] date 12/12/07

Improvement Permit by: [signature] date 12-12-07

Authorization to Construct by: [signature] date 12-12-07

Installed by: Martin Dudek Septic


Operation Permit by: [signature] date 6-4-08

Existing System Inspection by: date

HEALTH DEPT. COPY: WHITE OWNER COPY (FINAL): YELLOW OWNER COPY (INITIAL): PINK

Permit # 138427
Pin # 4713630211

THIS PROPERTY MAY BE SUBJECT TO RECORDED OR UNRECORDED RIGHTS OF WAYS OR EASEMENTS NOT OBSERVED.

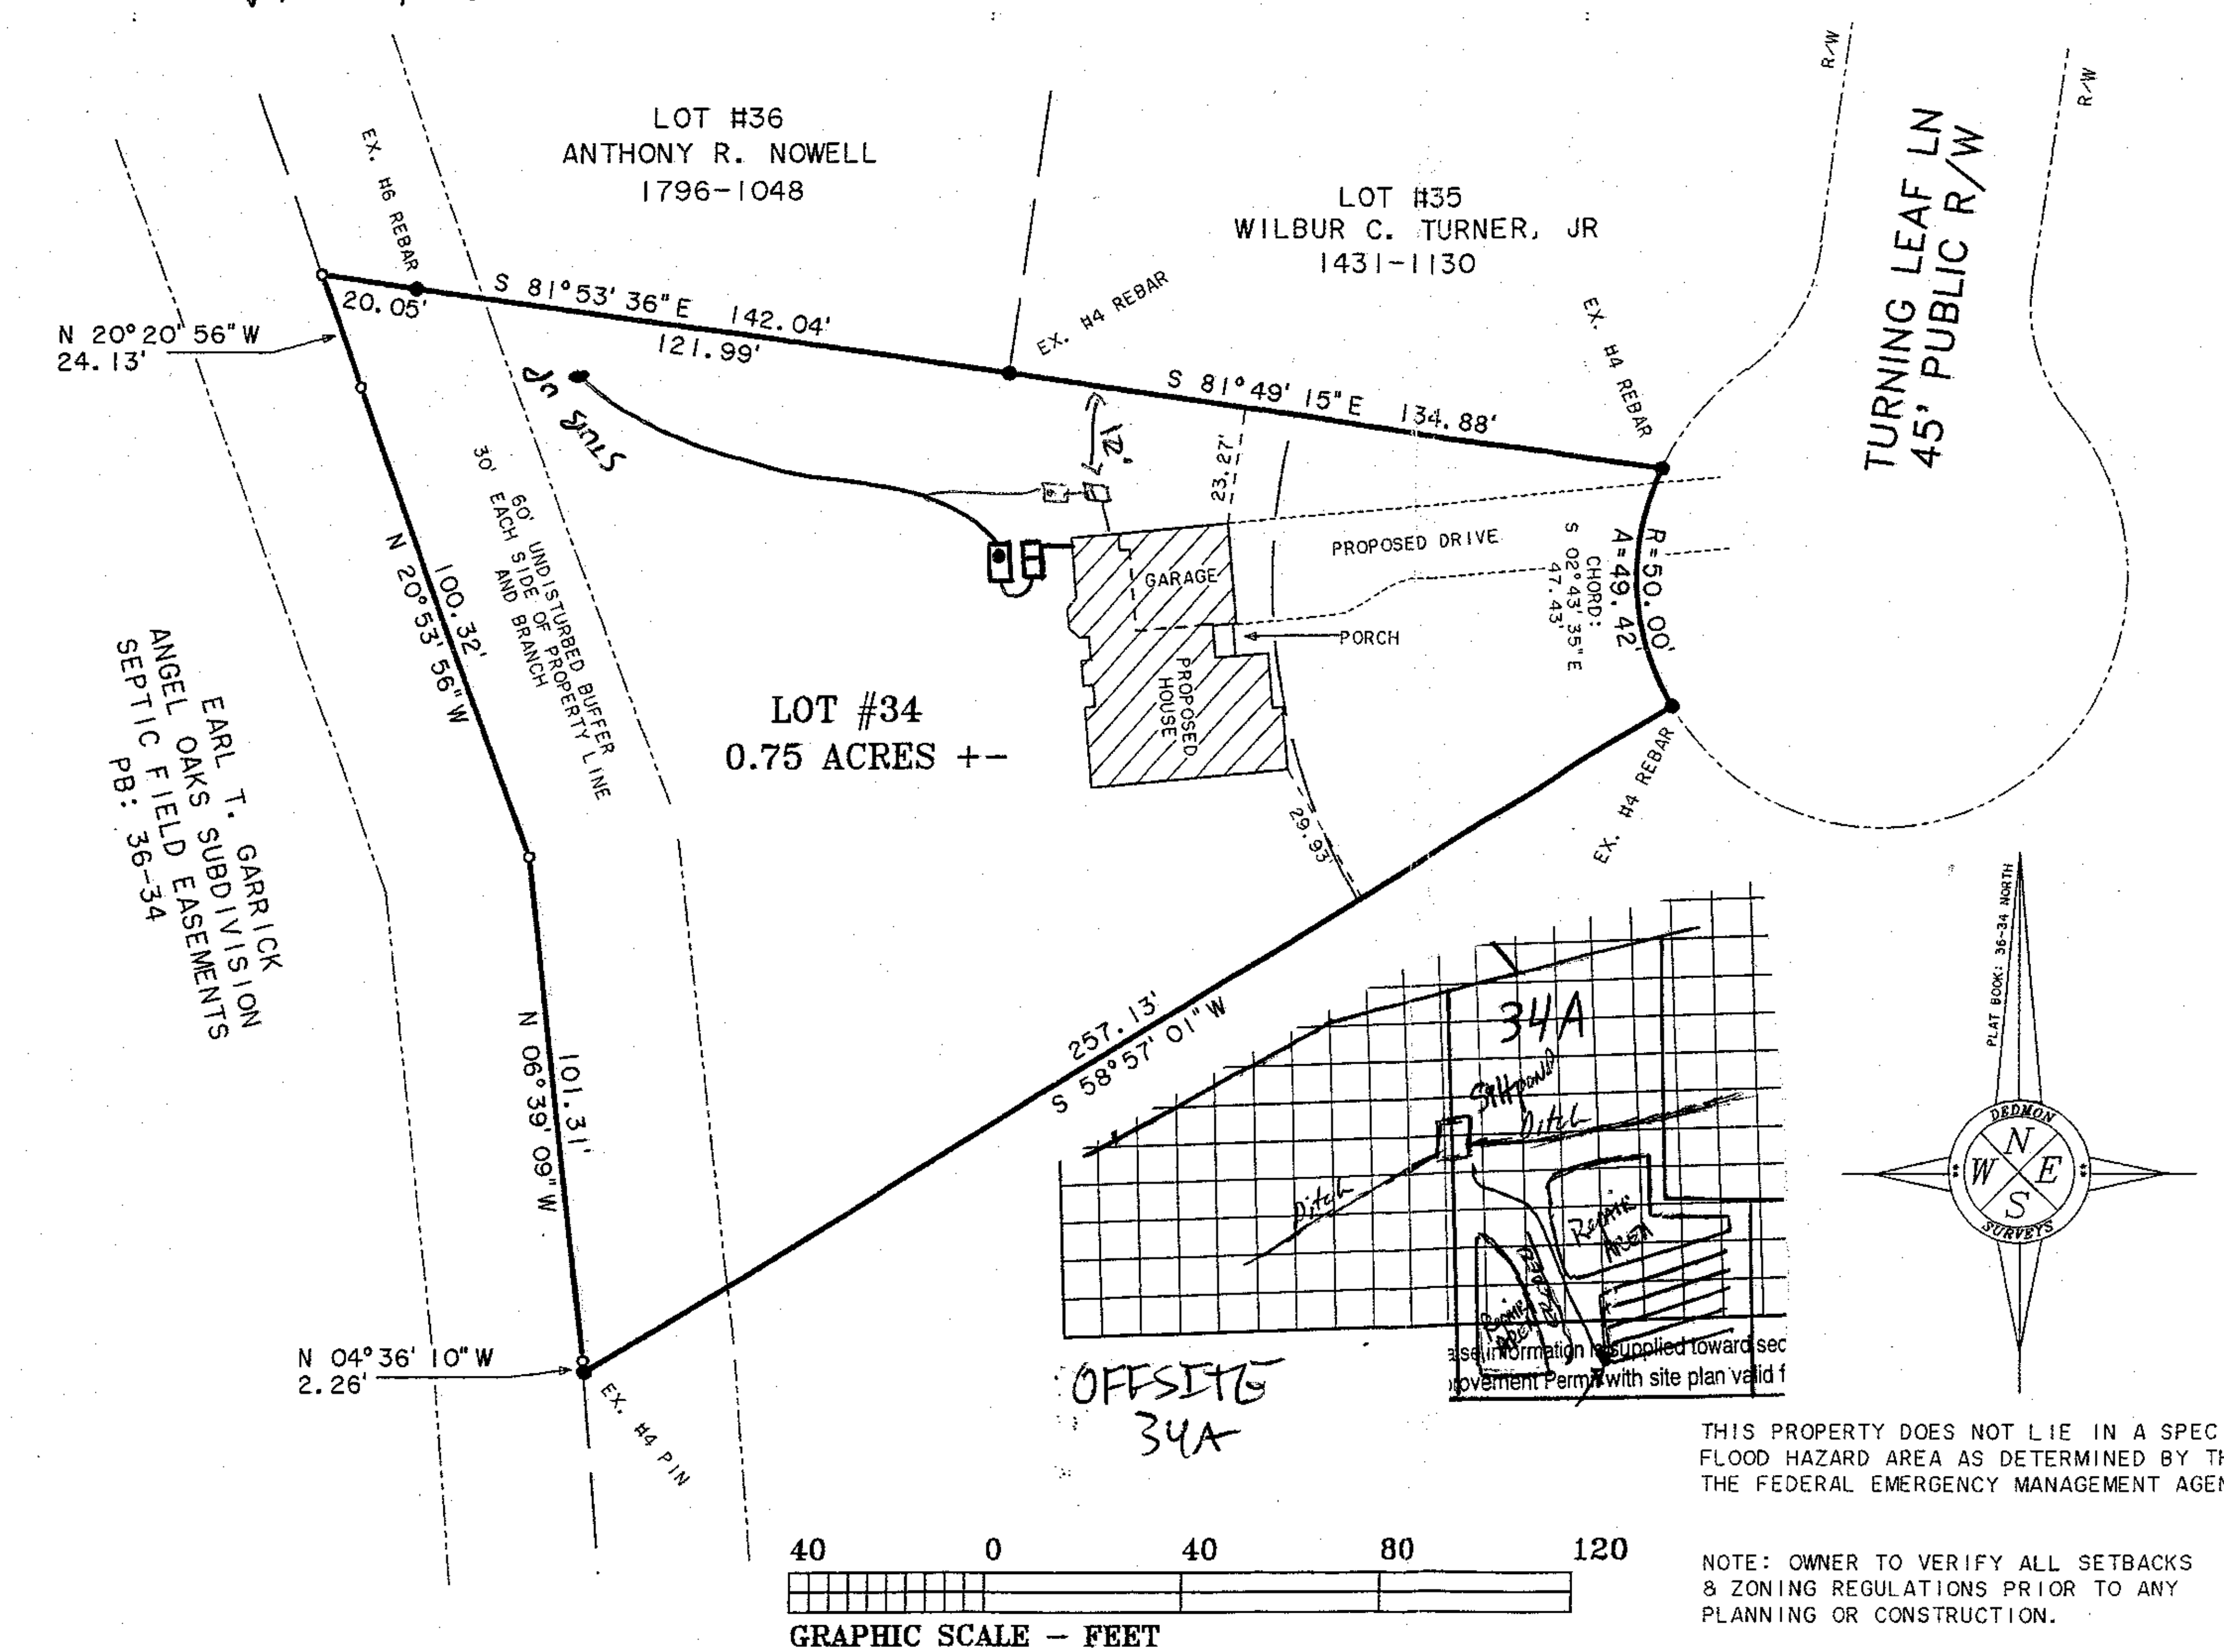

THIS PROPERTY DOES NOT LIE IN A SPECIAL FLOOD HAZARD AREA AS DETERMINED BY THE THE FEDERAL EMERGENCY MANAGEMENT AGENCY.

NOTE: OWNER TO VERIFY ALL SETBACKS & ZONING REGULATIONS PRIOR TO ANY PLANNING OR CONSTRUCTION.

PHYSICAL SURVEY
FOR

EARL T. GARRICK

BEING ALL OF LOT #34 OF
ANGEL OAKS SUBDIVISION

OCTOBER 9, 2007 SCALE: 1" = 40'	DB: 1039 PG: 1721 DB: PG: PB: 36 PG: 34

SHILOH TOWNSHIP
IREDELL COUNTY, NORTH CAROLINA

RONNIE DEDMON SURVEYORS - P.A.

RONNIE DEDMON, PLS #1222
CHUCK POOVEY, PLS #3762
ROBERT DEDMON, PLS #3899
PHILLIP HARRIS, PLS #4164
4837 NC HIGHWAY #16 NORTH
P.O. BOX 494 - DENVER, N.C. 28037
PHONE: (704)-483-4908
FAX: (704)-483-2170

NORTH CAROLINA PROFESSIONAL SEAL L-4164 LAND SURVEYOR PHILLIP A. HARRIS


10-9-07

"I CERTIFY THIS PLAT WAS DRAWN FROM AN ACTUAL SURVEY AND IS CORRECT AND TRUE TO THE BEST OF MY KNOWLEDGE."

PROFESSIONAL LAND SURVEYOR — L-4164 LICENSE NO.

SURV. BY: BC	DRAWN BY: PHIL	JOB: A03334 SCR #: A034

VICINITY MAP NOT TO SCALE

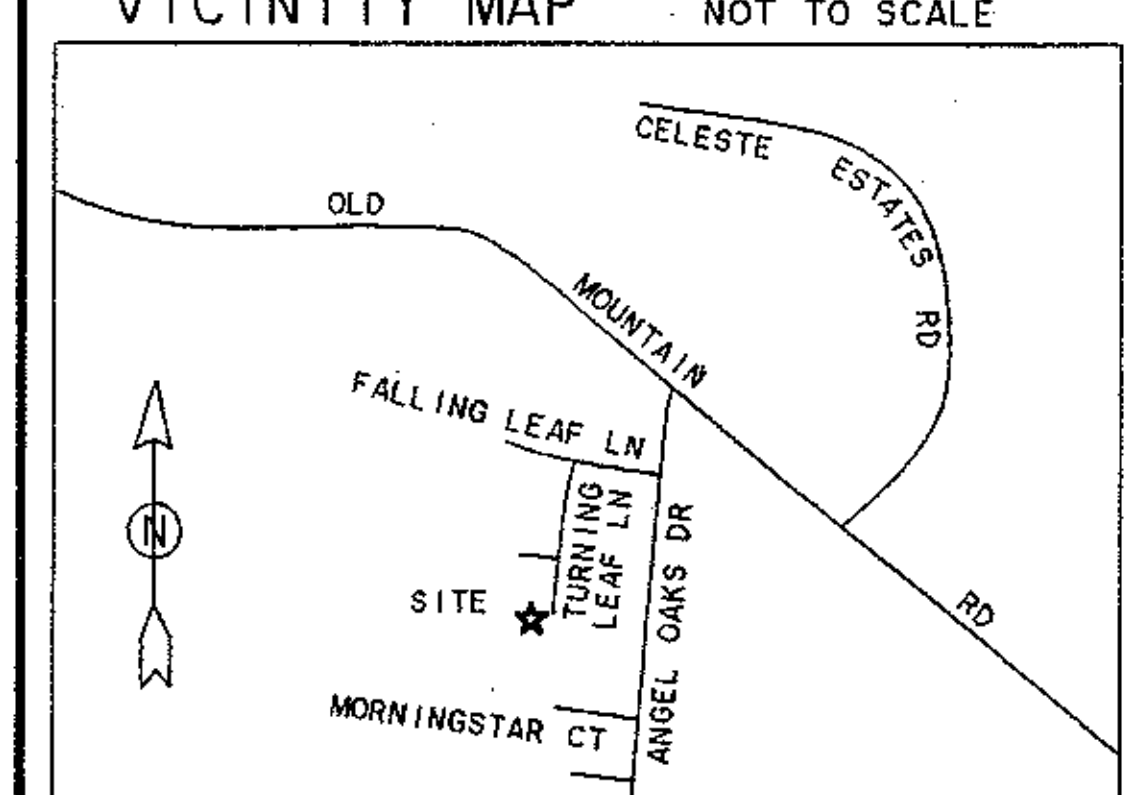

M-11363