CJ 125.00 Paid

IREDELL COUNTY HEALTH DEPARTMENT

STATESVILLE 704-878-5305 MOORESVILLE 704-664-5281

IMPROVEMENT PERMIT / AUTHORIZATION TO CONSTRUCT / OPERATION PERMIT / EXISTING SYSTEM INSPECTION

PERMIT# 089522 PIN# ~~4913632148 (pt)~~ 4713-63-0848 DATE March 12, 01

OWNER OR CONTRACTOR Earl Garrick PHONE: Business 374-9700 Home

ADDRESS 9815 J Sam Furr Rd. Huntersville NC 28078

LOCATION From Trantman Old Statesville Rd. TL Angel Oaks Drive TR Falling Leaf Lane on left near/at end

SUBDIVISION Angel Oaks BLOCK / SECTION LOT 40 LOT AREA 1.64 ac SITE CLASS. PS DESIGN FLOW 360gpd L.T.A.R. .3

Septic Tank: 1000 Gallons; STB 1007 Date 8-29-03
Pump Tank: 1000 Gallons; PT 274 Date 8-12-03
Pump Make: Zoeller Model N-152A Serial No. —
Nitrification Field: No Fields 1 Square Feet 900 Linear Feet 300
No Lines 6@50' Trench Width 36" Max Trench Bottom Depth 36" Gravel Depth NA

☑ New System ☐ Repair System Type: I, II, III, IV, V, VI
System Description: PM - Innovative 25% Red.
Repair System Description: LPPPBPS
Maintenance Agreement Required: ☐ Yes ☑ No Initially

☑ House/Mod. Home No. Bedrooms 3
☐ Mobile Home No. Bathrooms 2
☐ Business No. Employees
☐ Other

☐ Slab ☑ Crawl Space ☐ Basement w/plumbing ☐ Basement wo/plumbing


Water Supply: ☐ Individual ☑ Public ☐ Community

Comments:/Conditions:


Comments:/Conditions: ST Marker + Tiff - Tite Filter Installed - 48 Infiltrator Chambers Installed; Pressure Check okay 10-14-03 - Electrical + Alarm - okay 11-17-03

1"=50'

INITIAL SITE SKETCH

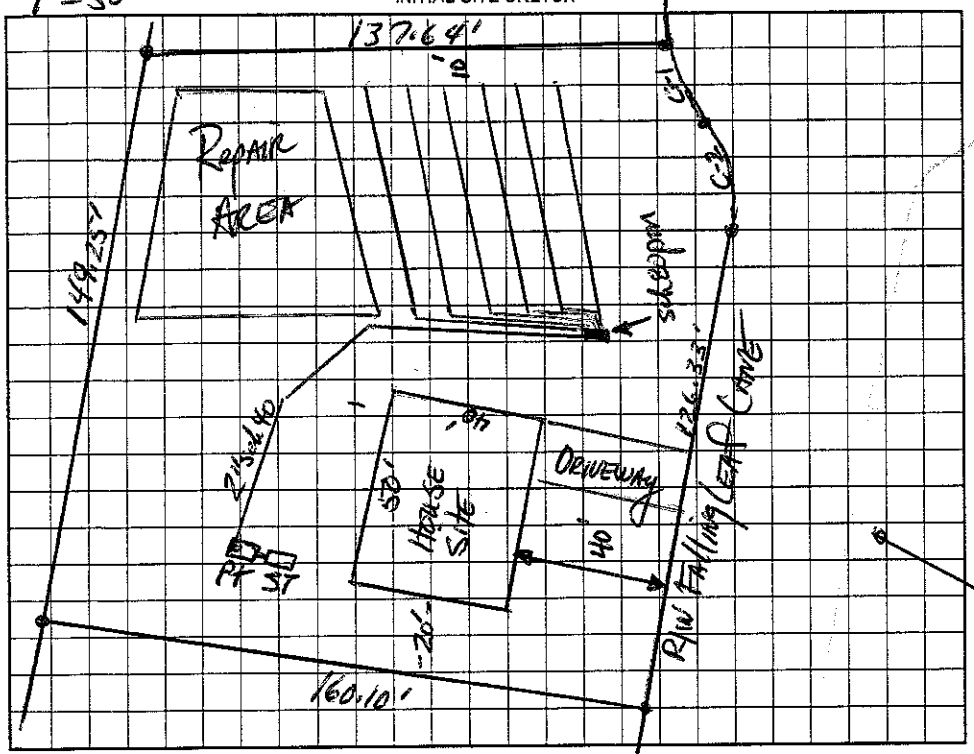

AS BUILT SKETCH

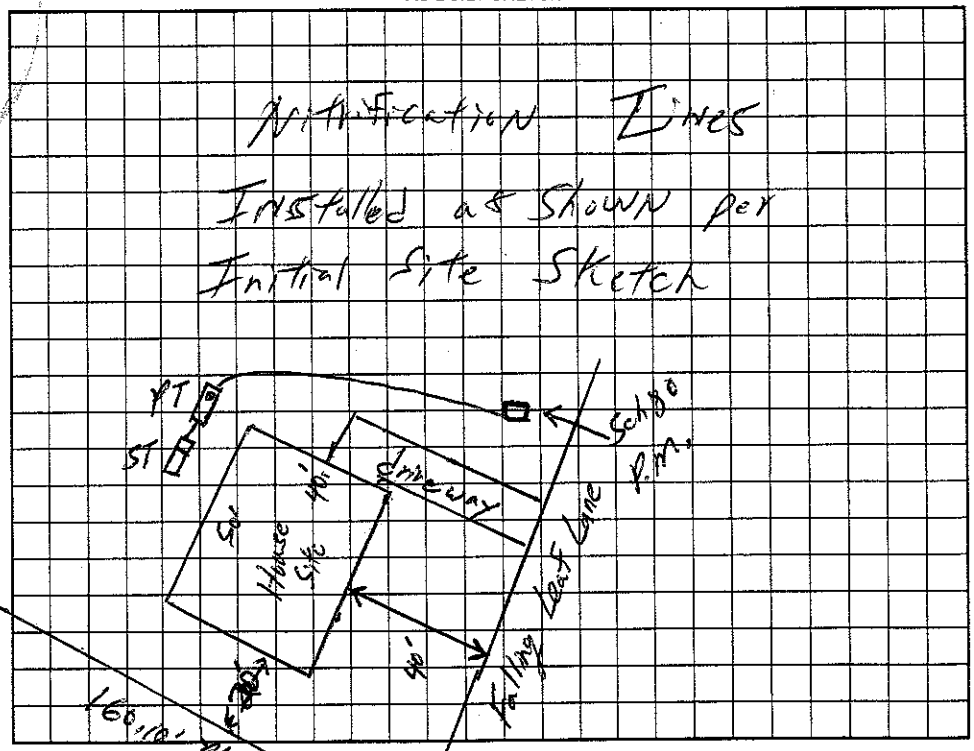

Permit can be suspended or revoked if any false information is supplied toward securing the permit/any unauthorized changes are made to the site/any unauthorized changes are made in the installation of the system. Improvement Permit with plat valid without expiration. Improvement Permit with site plan valid for sixty months. Authorization to Construct is valid for a period equal to that of Improvement Permit – not to exceed sixty months.

Signed: [signature] date 3-27-01

Improvement Permit by: [signature] date 3-12-01

Authorization to Construct by: [signature] date 08/05/03

Installed by: Sammy Shoemaker (10/14/03)

Operation Permit by: William O. Johnson date 11/17/03

Existing System Inspection by: date

HEALTH DEPT. COPY: WHITE OWNER COPY (FINAL): YELLOW OWNER COPY (INITIAL): PINK