rec. #125.00

IREDELL COUNTY HEALTH DEPARTMENT

STATESVILLE 704-878-5305 ✓ MOORESVILLE 704-664-5281

IMPROVEMENT PERMIT / AUTHORIZATION TO CONSTRUCT / OPERATION PERMIT / EXISTING SYSTEM INSPECTION

PERMIT# D00332 PIN# 4713632148 (pt) DATE Dec 19, 00

OWNER OR CONTRACTOR Earl Garrick PHONE: Business 374-9700 Home

ADDRESS 9665 J Sam Furr Rd. Huntersville NC 28078

LOCATION From Trenton Old Mtn Rd. TL Angel Oaks Rd TR Falling Leaf TL Turning Leaf on right at end

SUBDIVISION Angel Oaks BLOCK / SECTION LOT 35 LOT AREA .75 ac SITE CLASS PS DESIGN FLOW 360 gpd L.T.A.R. .25 ±

Septic Tank: 1000 Gallons: STB 1012 Date 1-16-01

Pump Tank: 1000 Gallons: PT 17 Date 8-22-00

Pump Make: Little Giant Model 10SHC-1A-PS Serial No

Nitrification Field: No Fields 1 Square Feet 1080 Linear Feet 360

No Lines 5 Trench Width 36" Max Trench Bottom Depth 36"

☑ New System ☐ Repair System Type I II III IV V

System Description: pmp Innovative - 35% Red.

Repair System Description: ~~Stone~~ pm 50% Red.

Maintenance Agreement Required: ☐ Yes ☑ No

Gravel Depth N/A ☐ Slab ☑ Crawl Space ☐ Basement w/plumbing ☐ Basement wo/plumbing

☐ House/Mod Home No. Bedrooms 3

☐ Mobile Home No. Bathrooms 2

☐ Business No. Employees

☐ Other


Water Supply: ☐ Individual ☑ Public ☐ Community

Comments/Conditions: Changed driveway to house to front entrance garage. Therefore changed Repair System to → PM - 50% Reduction.

Comments/Conditions: SEPTIC TANK W/ MARKER INSTALLED USING "Poly Lok" FILTER (2) SYSTEM CHANGED TO 4 x 90 LINES WITH PRIOR H.D. APPROVAL

1" = 50'

INITIAL SITE SKETCH

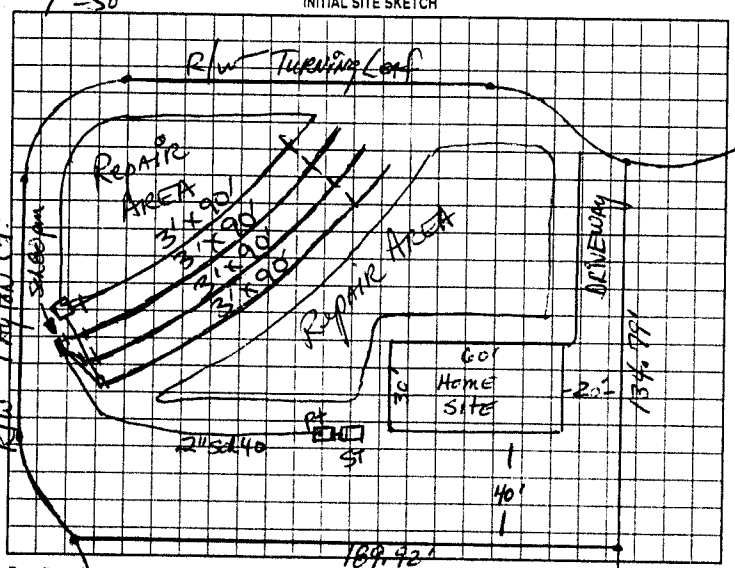

AS BUILT SKETCH

Please check Electrical + Alarm Box Logs

Installed as Shown Per Site Sketch

Permit can be suspended or revoked if any false information is supplied toward securing the permit/any unauthorized changes are made to the site/any unauthorized changes are made in the installation of the system. Improvement Permit with plat valid without expiration. Improvement Permit with site plan valid for sixty months. Authorization to Construct is valid for a period equal to that of Improvement Permit – not to exceed sixty months.

Signed: date

Improvement Permit by: date 12-19-00

Authorization to Construct by: RST date 7-12-01

Installed by: A-1 Backhoe

Operation Permit by: William C. Johnson date 9/28/01

Existing System Inspection by: date

HEALTH DEPT COPY: WHITE OWNER COPY (FINAL): YELLOW OWNER COPY (INITIAL): PINK