David Kruk Jr 204970

IREDELL COUNTY HEALTH DEPARTMENT

Pd. $125.00

STATESVILLE 704-878-5305 ✓ MOORESVILLE 704-664-5281

IMPROVEMENT PERMIT / AUTHORIZATION TO CONSTRUCT / OPERATION PERMIT / EXISTING SYSTEM INSPECTION

PERMIT# 08952D PIN# 4713632148 (pt.)

OWNER OR CONTRACTOR Earl Garrick PHONE: Business 374-9700 Home DATE Nov 19 00

ADDRESS 2815 I Sam Furr Rd. Huntersville NC. 28078

LOCATION 114 Turningleaf Ln. From Trackman - Old Statesville Rd. TL Angel Oaks Dr. TR Fallingleaf TL Turningleaf TR Payton - on Right

SUBDIVISION Angel Oaks BLOCK / SECTION ____ LOT 38 LOT AREA .78 Ac SITE CLASS PS DESIGN FLOW 360 gpd L.T.A.R. .3-.35 @ 36"

Septic Tank: 1000 Gallons: STB 1007 Date 2-29-02

Pump Tank: 1000 Gallons: PT 274 Date 2-2-02

Pump Make: Ewing Model WARS5-1 Serial No. —

Nitrification Field: No Fields 1 Square Feet 1140 Lineal Feet 380

No Lines 5 Trench Width 36" Trench Bottom Depth 36" Gravel Depth 12"

☑ New System ☐ Repair System Type: I, II, III, IV, V, VI

System Description: PM1 - CONVENTIONAL

Repair System Description: PM1 - INNOVATIVE-25% Red.

Maintenance Agreement Required: ☐ Yes ☐ No

☑ House/Mod. Home No. Bedrooms 3

☐ Mobile Home No. Bathrooms 2

☐ Business No. Employees ____

☐ Other ____

☐ Slab ☑ Crawl Space ☐ Basement w/plumbing ☐ Basement wo/plumbing


Water Supply: ☐ Individual ☑ Public ☐ Community

Comments/Conditions: Install Laterals at 36" trench bottom.

Comments/Conditions: S.T. Marker Installed 4/4/02 wgf
- Polylok filter Installed, Lines Okay wgf
- Pressure Check Okay - 4/12/02 wgf
- Electrical + Alarm Okay - 5/15/02 wgf

1" = 50'

INITIAL SITE SKETCH

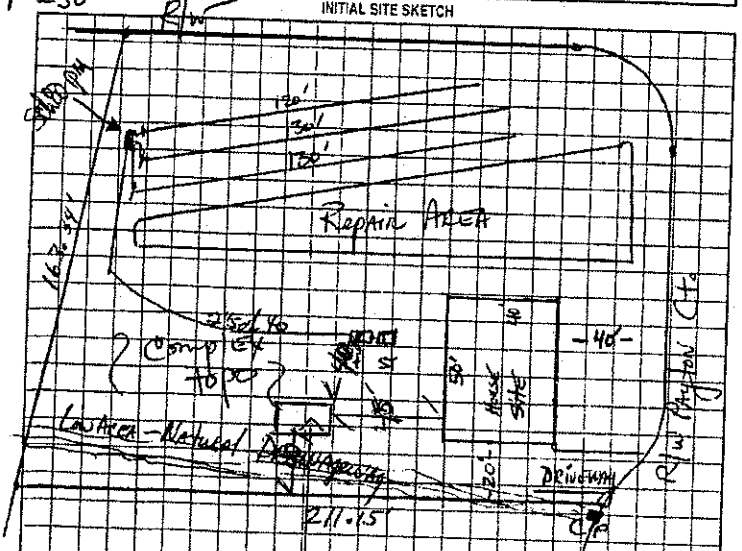

AS BUILT SKETCH

Location of the proposed 28'x14' Shed addition does not appear to impact the existing on-site septic system or well.**NOTE:

REHS Date: 07/14/13

ICHD-Environmental Health Division

Site Sketch

Permit can be suspended or revoked if any false information is supplied toward securing the permit/any unauthorized changes are made to the site/any unauthorized changes are made in the installation of the system. Improvement Permit with plat valid without expiration. Improvement Permit with site plan valid for sixty months. Authorization to Construct is valid for a period equal to that of Improvement Permit - not to exceed sixty months.

Signed:

Improvement Permit by: ____ date ____

Authorization to Construct by: ____ date 12-19-00

Installed by: Statesville Backhoe Service

Operation Permit by: ____ date 4/8/02

Existing System Inspection by: ____ date 5/15/02

HEALTH DEPT. COPY. WHITE OWNER COPY (FINAL). YELLOW OWNER COPY (INITIAL) PINK

28' x 14' Shed