IREDELL COUNTY HEALTH DEPARTMENT

STATESVILLE 704-878-5305 125.00 Paid MOORESVILLE 704-664-5281

IMPROVEMENT PERMIT / AUTHORIZATION TO CONSTRUCT / OPERATION PERMIT / EXISTING SYSTEM INSPECTION

PERMIT# 089521 PIN# 4713632148 (pt.) DATE March 12, 01

OWNER OR CONTRACTOR Earl Garrick PHONE: Business 324-9700 Home

ADDRESS 9815 J Sam Furr Rd. Mooresville NC 28078

LOCATION From Troutman old NTH TR TL Angel Oaks Dr TR Falling Leaf Ln on left at jct w/ Turning Leaf Ln.

SUBDIVISION Angel Oaks BLOCK / SECTION LOT 39 LOT AREA 0.546 Ac SITE CLASS PS DESIGN FLOW 360 gpd L.T.A.R. 0.3 > 0.12"

Septic Tank: 1000 Gallons; STB 1012 Date 4-21-01
Pump Tank: 1000 Gallons; PT 17 Date 6-16-01
Pump Make: Hydromatic Model SK60M1 Serial No 51334-046-7
Nitrification Field: No Fields 1 Square Feet 900 Linear Feet 300
No Lines 3 Trench Width 36" Trench Bottom Depth 36"* Gravel Depth N/A

☑ New System ☐ Repair System Type: I II III IV V VI
System Description: PM- INNOVATIVE -25% Red.
Repair System Description: LPP1885 / may be Innov.
Maintenance Agreement Required: ☐ Yes ☑ No
☐ Slab ☑ Crawl Space ☐ Basement w/plumbing ☐ Basement wo/plumbing

☑ House/Mod. Home No. Bedrooms 3
☐ Mobile Home No. Bathrooms 2
☐ Business No. Employees
☐ Other


Water Supply: ☐ Individual ☑ Public ☐ Community

Comments/Conditions: * Install Laterals at 36" trench bottom depth.


Comments/Conditions: POLY LOK FILTER & MARKER
TANKS & LINES √'D/ NEEDS PRESSURE & ELECTRICAL LL 8-24-01

1"=50'

INITIAL SITE SKETCH

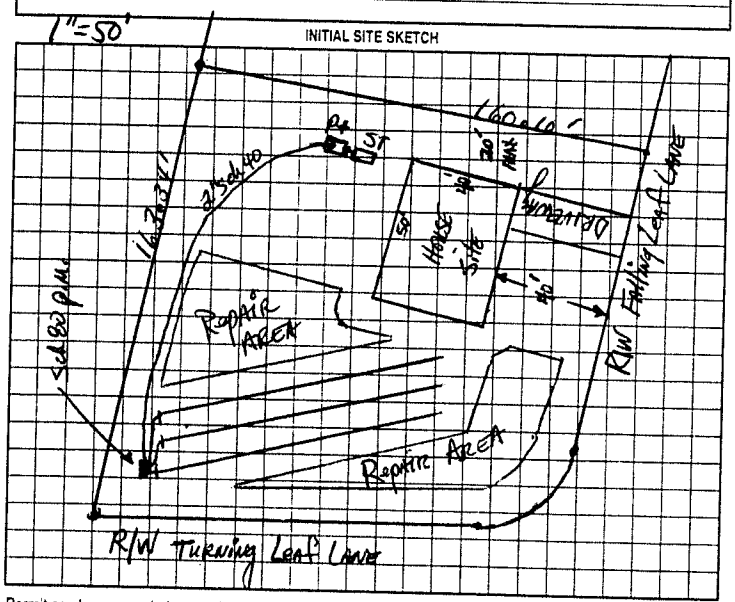

AS BUILT SKETCH

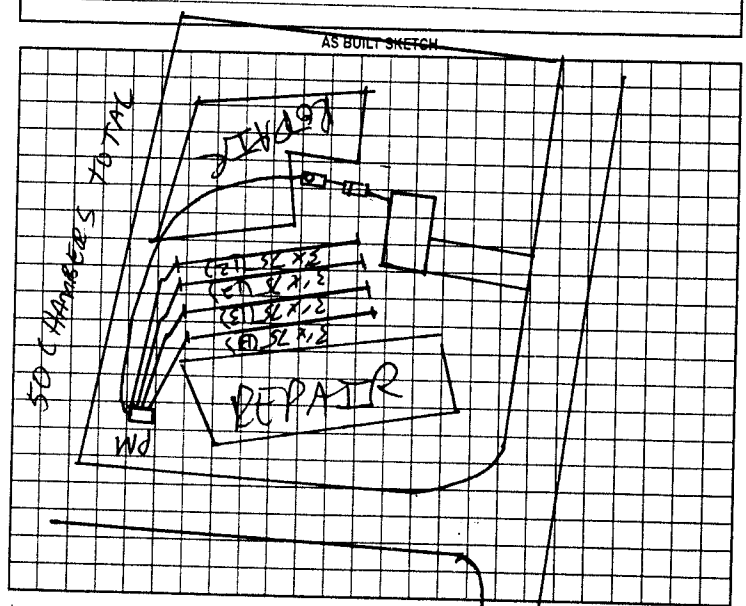

Permit can be suspended or revoked if any false information is supplied toward securing the permit/any unauthorized changes are made to the site/any unauthorized changes are made in the installation of the system. Improvement Permit with plat valid without expiration. Improvement Permit with site plan valid for sixty months. Authorization to Construct is valid for a period equal to that of Improvement Permit – not to exceed sixty months.

Signed: [signature]

Improvement Permit by: [signature] RS date 3-27-01

Authorization to Construct by: [signature] RS date 3-12-01

Installed by: A-1 BACKHOE

Operation Permit by: STEVE HEARICK date 9-24-01

Existing System Inspection by: date

HEALTH DEPT. COPY: WHITE OWNER COPY (FINAL): YELLOW OWNER COPY (INITIAL): PINK