IREDELL COUNTY HEALTH DEPARTMENT

STATESVILLE 704-878-5305 MOORESVILLE 704-664-5281

IMPROVEMENT PERMIT / AUTHORIZATION TO CONSTRUCT / OPERATION PERMIT / EXISTING SYSTEM INSPECTION

PERMIT# 089334 PIN# 4713632148 (Lot) DATE Jan. 30, 01

OWNER OR CONTRACTOR Ethel Garrick PHONE: Business 374-9700 Home

ADDRESS 9815 J Sam Furr Rd, Huntersville, N.C. 28078

LOCATION From Trantham Old Mtn Rd. TL Angel Oaks Drive on Right before Mornington St.

SUBDIVISION Angel OAKS BLOCK / SECTION LOT 25 LOT AREA .76Ac SITE CLASS. PS DESIGN FLOW 360gpd L.T.A.R. .25-.3

Septic Tank: 1000 Gallons: STB 1012 Date 9-25-01

Pump Tank: Gallons: PT Date

Pump Make: Model Serial No.

Nitrification Field: No Fields 1 Square Feet 900 Linear Feet 300

No Lines 4 Trench Width 36" Trench Bottom Depth 36" Gravel Depth NA

☑ New System ☐ Repair System Type: I. II. III. IV. V. VI

System Description: Gravity Innovative-25% Red.

Repair System Description: Same

Maintenance Agreement Required: ☐ Yes ☑ No

☐ Slab ☑ Crawl Space ☐ Basement w/plumbing ☐ Basement wo/plumbing

☐ House/Mod. Home No. Bedrooms 3

☐ Mobile Home No. Bathrooms 2

☐ Business No. Employees

☐ Other

Water Supply: ☐ Individual ☒ Public ☐ Community

Comments:/Conditions:


Install Laterals at 36" trench bottom depth.

Comments /Conditions


- In ft Water Chambers Installed
- Poly Lok Filter Installed
- Septic Tank marker Installed

1"=50'

INITIAL SITE SKETCH

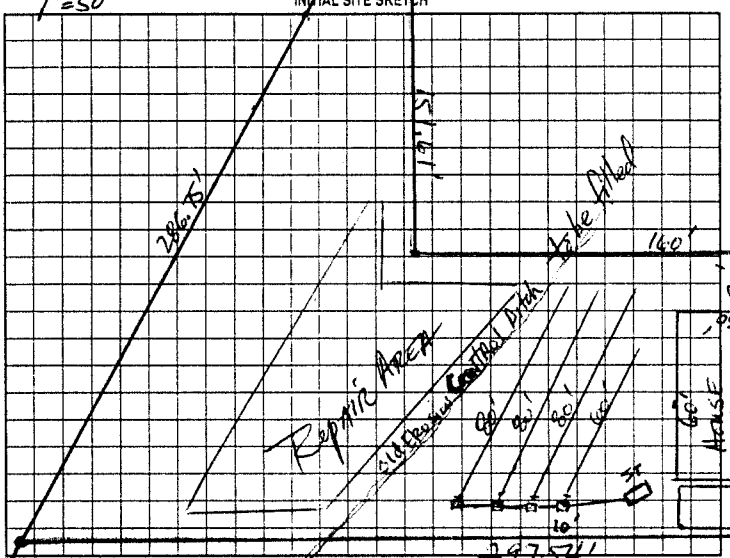

AS BUILT SKETCH

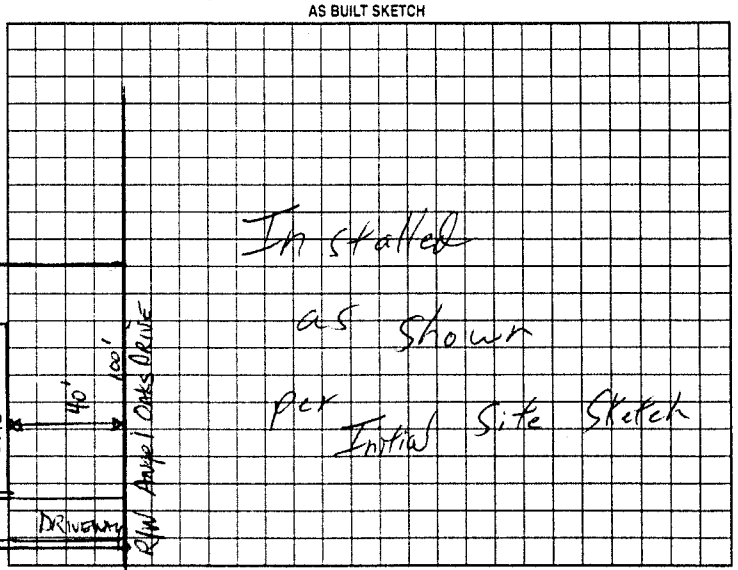

Permit can be suspended or revoked if any false information is supplied toward securing the permit/any unauthorized changes are made to the site, any unauthorized changes are made in the installation of the system. Improvement Permit with plat valid without expiration. Improvement Permit with site plan valid for sixty months. Authorization to Construct is valid for a period equal to that of Improvement Permit – not to exceed sixty months.

Signed: date

Improvement Permit by: date 1-30-01

Authorization to Construct by: date 12/5/01

Installed by: At Backhoe

Operation Permit by: date 1/29/02

Existing System Inspection by: date

HEALTH DEPT COPY WHITE OWNER COPY (FINAL) YELLOW OWNER COPY (INITIAL) PINK