This Permit Voids previously issued Permit dated 10/25/00.

IREDELL COUNTY HEALTH DEPARTMENT

STATESVILLE 704-878-5305 CI MOORESVILLE 704-664-5281

IMPROVEMENT PERMIT / AUTHORIZATION TO CONSTRUCT / OPERATION PERMIT / EXISTING SYSTEM INSPECTION

PERMIT# 087518 PIN# 4713-63-2148 (pt) DATE Nov. 14, 2002

OWNER OR CONTRACTOR Earl Garrick PHONE: Business 374-9200 Home

ADDRESS 9815-J Sam Furr Rd Huntersville NC 28078

LOCATION From Trantham - 115 into Rd, (L) Angel Oaks Drive (R) Falling Leaf Lane, (L) Turning Leaf Lane 2nd Lot on Left

SUBDIVISION Angel Oaks BLOCK / SECTION LOT 36 LOT AREA .88 Ac SITE CLASS IS (Fine) DESIGN FLOW 360 L.T.A.R. .25 (Fine)

Septic Tank: 1,000 Gallons: STB 1012 Date 7-8-02
Pump Tank: Gallons: PT Date
Pump Make: Model Serial No.
Nitrification Field: No Fields 1 Square Feet 1440 Linear Feet 480
No Lines 8 @ 60' Trench Width 36" Max Trench Bottom Depth 36" Gravel Depth 12"

X New System ☐ Repair System Type: I (II) III IV V VI
System Description: Gravity, Conventional
Repair System Description: Pump, LPP
Maintenance Agreement Required: ☐ Yes X No

X House/Mod. Home No. Bedrooms 3
☐ Mobile Home No. Bathrooms 3
☐ Business No. Employees
☐ Other

☐ Slab X Crawl Space ☐ Basement w/plumbing ☐ Basement wo/plumbing

Water Supply: ☐ Individual X Public ☐ Community


Comments/Conditions:

(Not to Scale)

Comments/Conditions:

- Taf-Tite Filter Installed
- S.T. marker Installed

INITIAL SITE SKETCH

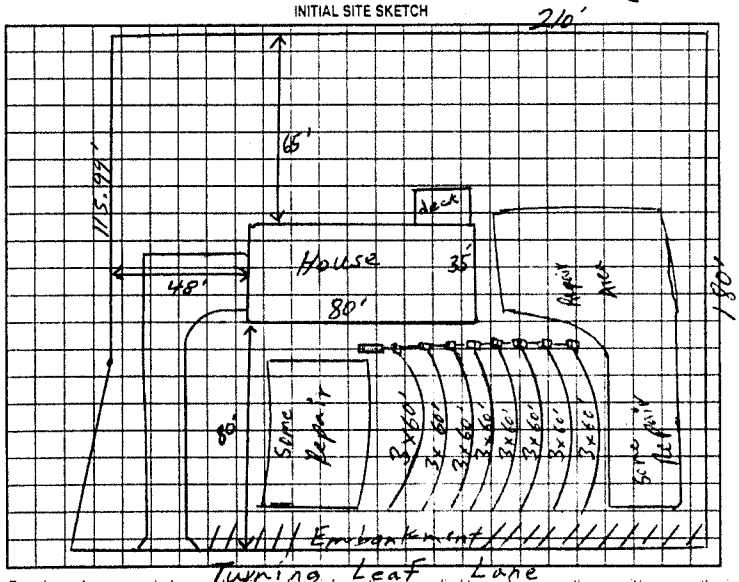

AS BUILT SKETCH

Installed as Shown per Initial Site Sketch

Permit can be suspended or revoked if any false information is supplied toward securing the permit/any unauthorized changes are made to the site any unauthorized changes are made in the installation of the system. Improvement Permit with plat valid without expiration. Improvement Permit with site plan valid for sixty months. Authorization to Construct is valid for a period equal to that of Improvement Permit – not to exceed sixty months.

Signed: Dennis Dalleker date

Improvement Permit by: William O Johnson date 11/14/02

Authorization to Construct by: William O Johnson date 11/14/02

Installed by A-1 Backhoe

Operation Permit by: William O Johnson date 11/14/02

Existing System Inspection by: date

HEALTH DEPT. COPY WHITE OWNER COPY (FINAL) YELLOW OWNER COPY (INITIAL) PINK