IREDELL COUNTY HEALTH DEPARTMENT

STATESVILLE 704-878-5305 ✓ MOORESVILLE 704-664-5281

IMPROVEMENT PERMIT / AUTHORIZATION TO CONSTRUCT / OPERATION PERMIT / EXISTING SYSTEM INSPECTION

PERMIT# 089519 PIN# 4713632148 (pt) DATE Dec 4, 00

OWNER OR CONTRACTOR EARL GARRICK PHONE: Business 622-3474 RICK Home

ADDRESS 9815 E SAM FURR RD HUNTERSVILLE NC 28078

LOCATION From Treadmill . Old MAN Rd. TL Angel OAKS DR. TR FallingLeaf TL TURNING LEAF ON left - CORNER 6T

SUBDIVISION Angel OAKS BLOCK / SECTION LOT 29 LOT AREA .59 AC SITE CLASS PS DESIGN FLOW 360 gpd L.T.A.R. .25-.35±

Septic Tank: 1000 Gallons; STB 1012 Date 8-12-4

Pump Tank: Gallons; PT Date

Pump Make: Model Serial No.

Nitrification Field: No Fields 1 Square Feet 1320 Linear Feet 440

No Lines 4 @ 110 Trench Width 36" Trench Bottom Depth 36"

☑ New System ☐ Repair System Type: I. II. III. IV. V. VI

System Description: GRAVITY CONVENTIONAL

Repair System Description: ~~GRAVITY~~ INNOVATIVE

Maintenance Agreement Required: ☐ Yes ☑ NO Ref.

Gravel Depth 12"

☑ House/Mod. Home No. Bedrooms 3

☐ Mobile Home No. Bathrooms 2

☐ Business No. Employees

☐ Other

☐ Slab ☑ Crawl Space ☐ Basement w/plumbing ☐ Basement wo/plumbing

Water Supply: ☐ Individual ☑ Public ☐ Community


Comments:/Conditions: INSTALLER NOTE: ALL CATERALS to be installed At 36" trench bottom. Do NOT backfill trenches with compacted Soil OR debris MATERIAL ENCOUNTERED. Do NOT cut or Power hose SITE otherwise USE of a Sand MAY be Required.

Comments:/Conditions: DRIVEWAY CHANGED & WILL NOT INTERFERE WITH DRIVEWAY


- Polylok Filter Installed
- Septic Tank Marker Installed

1"=50'

INITIAL SITE SKETCH

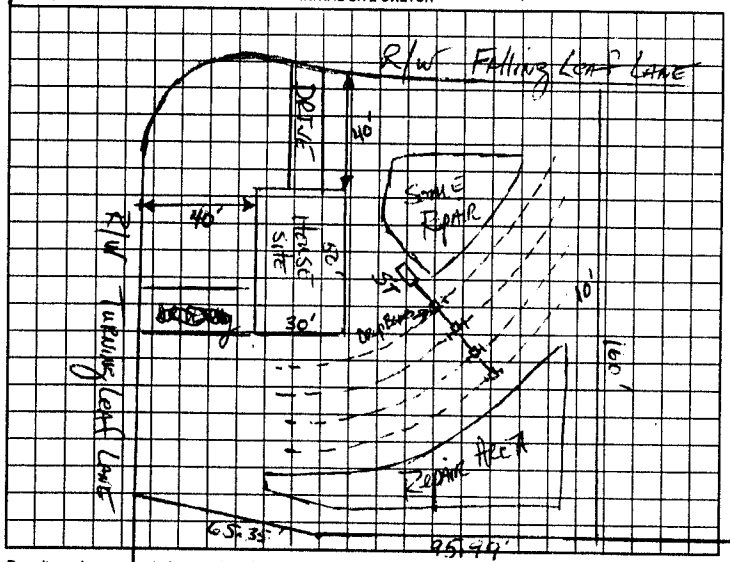

AS BUILT SKETCH

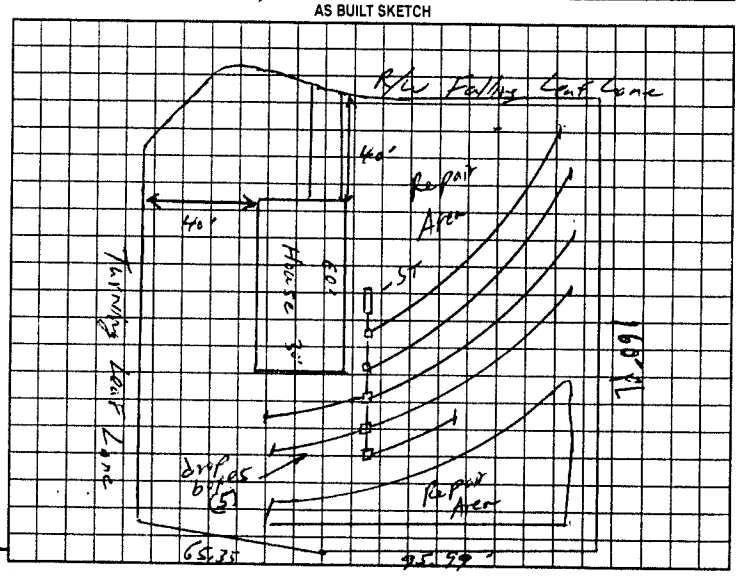

Permit can be suspended or revoked if any false information is supplied toward securing the permit/any unauthorized changes are made to the site/any unauthorized changes are made in the installation of the system. Improvement Permit with plat valid without expiration. Improvement Permit with site plan valid for sixty months. Authorization to Construct is valid for a period equal to that of Improvement Permit – not to exceed sixty months.

Signed: date

Improvement Permit by: date 12-4-00

Authorization to Construct by: date 8-22-01

Installed by: A-1 Backhoe

Operation Permit by: William G. Johnson date 10/24/01

Existing System Inspection by: date

HEALTH DEPT. COPY: WHITE OWNER COPY (FINAL): YELLOW OWNER COPY (INITIAL): PINK