~~Date Project Began~~ 01/11 site address 126 Falling Leaf Lane

IREDELL COUNTY HEALTH DEPARTMENT

STATESVILLE 704-878-5305 MOORESVILLE 704-664-5281

IMPROVEMENT PERMIT / AUTHORIZATION TO CONSTRUCT / OPERATION PERMIT / EXISTING SYSTEM INSPECTION

PERMIT# 13843 PIN# ~~4773-63-4285~~ ~~4773-64-1946~~ 4713634285 DATE 2-12-07

OWNER OR APPLICANT Aged OAKS DEVELOPMENT PHONE: Business 704-942-6466 Home

ADDRESS 9315 Iron Ridge Square 271 Harrisburg NC 28078

LOCATION 49 West @ Oldham Rd @ Meadows on rt

SUBDIVISION Aged OAKS BLOCK / SECTION LOT 26 LOT AREA .65 SITE CLASS PS DESIGN FLOW 360 L.T.A.R. .5

Septic Tank: 1000 Gallons; STB 312 Date 7-24-07

Pump Tank: Gallons; PT Date

Pump Make: Model Serial No.

Nitrification Field: No Fields / Square Feet EU=1200 Linear Feet 3001

No Lines 3 x 100 ~~90~~ Trench Width 36 Trench Bottom Depth 36" Gravel Depth N/A

☒ New System ☐ Repair ☐ Expansion System Type: I II III IV V VI

System Description: 60x3M 254 Bundle

Repair System Description: LP 56 Header

Maintenance Agreement Required: ☐ Yes ☒ No

☒ House/Mod. Home ☐ Mobile Home ☐ Business ☐ Other

No. Bedrooms 3 No. Persons 6 No. Employees

Water Supply: ☐ Individual ☒ Public ☐ Community

☒ Gravity ☐ Pressure ☐ Slab ☒ Crawl Space ☐ Basement w/plumbing ☐ Basement wo/plumbing

Comments:/Conditions: (1) INSTALL DRAIN LINES AT 36" DEEP (2) Fill MUST BE REMOVED BY OP IS ISSUED (3) INSTALL LINES ON CONTOURS & MAINTAIN SETBACKS

Comments:/Conditions: POLYLOK Filter & MARLOW

60 40

60 40 SYSTEM 10' OFF MARKED P/L

60 40

INITIAL SITE SKETCH

SEE ATTACHED SYSTEM DESIGN BY LOCKE COOK R.S.

AS BUILT SKETCH

(1) ISF LEFT ON 10-2-07 HAD TO MOVE DUE TO DRAIN & POND LINE

(2) 10 & 7 Line V'D OK SYSTEM V'D

(3) NEEDS Fill Removed BY OP ISSUED ON POND SIDE NOT WITH SYSTEM

(4) Fill REMOVED & V'D 11-13-07

Permit can be suspended or revoked if any false information is supplied toward securing the permit/any unauthorized changes are made to the site/any unauthorized changes are made in the installation of the system. Improvement Permit with plat valid without expiration ☐ Improvement Permit with site plan valid for sixty months ☒ Authorization to Construct is valid for a period equal to that of Improvement Permit – not to exceed sixty months.

Signed date 2/13/07 Installed by: MARTY DICKE

Improvement Permit by: date 2-12-07 Operation Permit by: date 11-13-07

Authorization to Construct by: date 2-12-07 Existing System Inspection by: date

HEALTH DEPT. COPY: WHITE OWNER COPY (FINAL): YELLOW OWNER COPY (INITIAL): PINK


THIS PROPERTY MAY BE SUBJECT TO RECORDED OR UNRECORDED RIGHTS OF WAYS OR EASEMENTS NOT OBSERVED.

THIS PROPERTY DOES NOT LIE IN A SPECIAL FLOOD HAZARD AREA AS DETERMINED BY THE THE FEDERAL EMERGENCY MANAGEMENT AGENCY.

NOTE: OWNER TO VERIFY ALL SETBACKS & ZONING REGULATIONS PRIOR TO ANY PLANNING OR CONSTRUCTION.

Permit # 138431

PIN # 4713634285

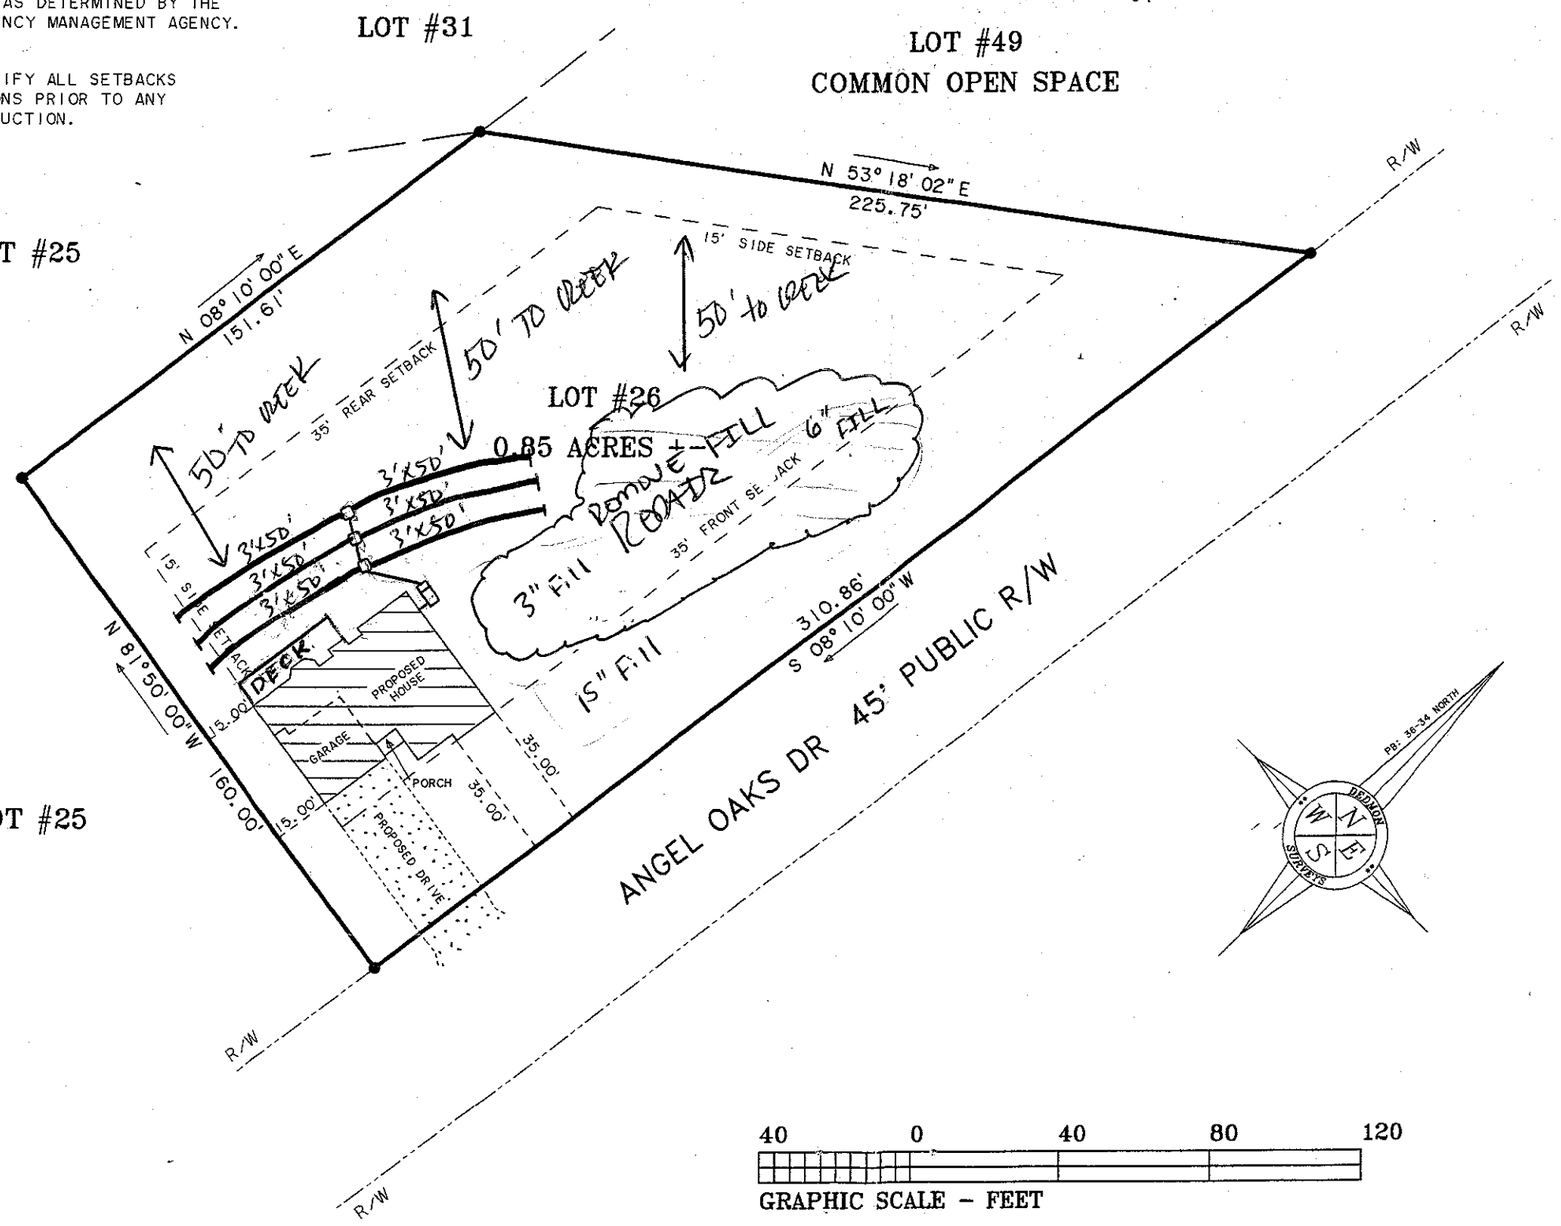

40 0 40 80 120

GRAPHIC SCALE - FEET

DEDMON SURVEYS

SITE PLAN
FOR

PREMIER DEVELOPERS, INC.

BEING ALL OF LOT #26 OF
ANGEL OAKS SUBDIVISION

SEPTEMBER 29, 2006	DB: 1039	PG: 1721
SCALE: 1" = 40'	DB:	PG:
	PB: 36	PG: 34

SHILOH TOWNSHIP
IREDELL COUNTY, NORTH CAROLINA

RONNIE DEDMON SURVEYORS - P.A.

RONNIE DEDMON, PLS #1222
CHUCK POOVEY, PLS #3762
ROBERT DEDMON, PLS #3899
PHILLIP HARRIS, PLS #4164
4837 NC HIGHWAY #16 NORTH
P.O. BOX 494 - DENVER, N.C. 28037
PHONE: (704)-483-4908
FAX: (704)-483-2170

NORTH CAROLINA PROFESSIONAL SEAL L-4164 LAND SURVEYOR PHILLIP A. HARRIS


11-17-06

"THIS MAP IS A DRAFTED SITE PLAN ONLY. NO FIELD WORK HAS BEEN CONDUCTED AS OF THE DATE OF THIS PLAN."

PROFESSIONAL LAND SURVEYOR — L-4164 LICENSE NO.

SURV. BY:	DRAWN BY: PHIL	JOB: Q1A026

VICINITY MAP NOT TO SCALE

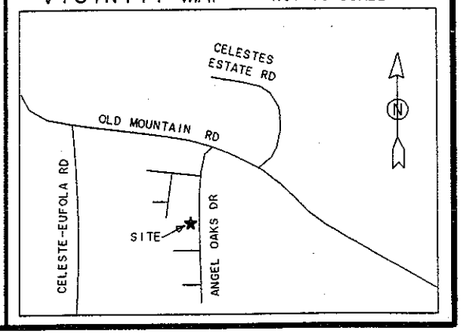

M-107011