# IREDELL COUNTY HEALTH DEPARTMENT

STATESVILLE 704-878-5305 MOORESVILLE 704-664-5281

## IMPROVEMENT PERMIT / AUTHORIZATION TO CONSTRUCT / OPERATION PERMIT / EXISTING SYSTEM INSPECTION

PERMIT# C89526 PIN# 4713632148 (pt) DATE Dec 4 00

OWNER OR CONTRACTOR Earl Garrick PHONE: Business 374-9700 Home

ADDRESS 9815 J Sam Furr Rd Huntersville N.C. 28078

LOCATION From Trantham Old Mtn. Rd. TL Angel Oaks Dr. on Right at jct w/ Falling Leaf Lane

SUBDIVISION Angel Oaks BLOCK / SECTION LOT 28 LOT AREA .66± SITE CLASS PS DESIGN FLOW 360 gpd L.T.A.R. ~.35±

Septic Tank: 1000 Gallons; STB 1012 Date 8-2-01
Pump Tank: 1000 Gallons; PT 17 Date 4-30-01
Pump Make: Hydromatic Model SK 50 A1 Serial No. 5165-42-7
Nitrification Field: No Fields 1 Square Feet 720 Linear Feet 240
No Lines 4@60' Trench Width 36" Trench Bottom Depth 36" Gravel Depth NA

☑ New System ☐ Repair System Type: I, II, III, IV, V, VI
System Description: PM - Panel Block
Repair System Description: LP Panel Block
Maintenance Agreement Required: ☐ Yes ☑ No initially
☐ Slab ☑ Crawl Space ☐ Basement w/plumbing ☐ Basement wo/plumbing


☐ House/Mod. Home No. Bedrooms 3
☐ Mobile Home No. Bathrooms 2
☐ Business No. Employees
☐ Other

Water Supply: ☐ Individual ☐ Public ☐ Community


Comments/Conditions: Installer Note! Laterals to be installed at 36" trench bottom. Remove any debris/compacted soil on bp. Backfill w/ PS soil only.

Comments/Conditions: (LC) 8-13-01 NEEDS BACKLINE SURVEYED B-4 AC ISSUED TO RESTAKE/SIT P/L.
8-16-01 SYSTEM FLAGGED OUT, OUT OF CONTOUR! NEEDS TO REGRADE & TAKE OFF THE FILL DIRT. THEN IT WILL BE IN CONTOUR.
(BZ) Health Dept gave prior Approval to mon ST & PT before Const. Okay 10-25-01, Engr - Land Tech.

1" = 50' INITIAL SITE SKETCH

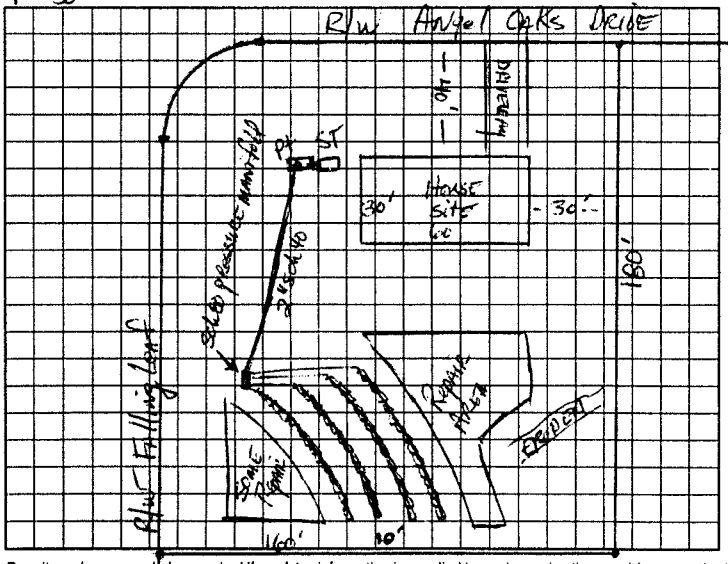


AS BUILT SKETCH Approval to mon ST & PT before Const.

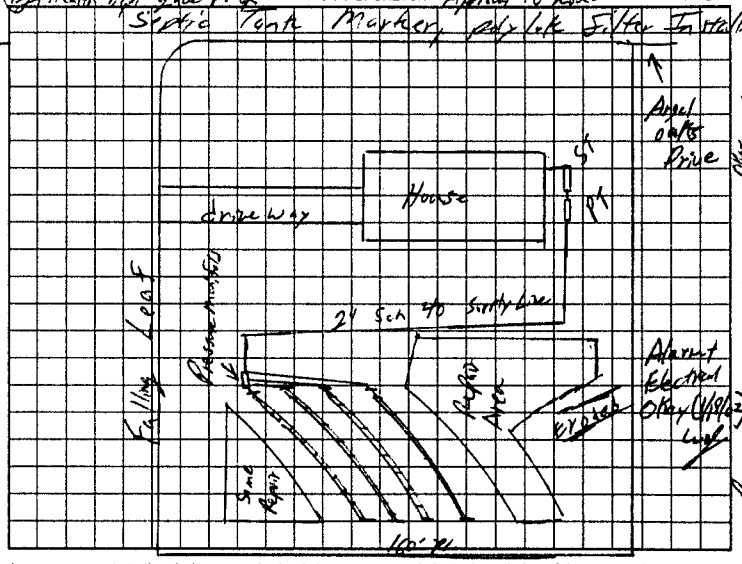


Permit can be suspended or revoked if any false information is supplied toward securing the permit/any unauthorized changes are made to the site/any unauthorized changes are made in the installation of the system. Improvement Permit with plat valid without expiration. Improvement Permit with site plan valid for sixty months. Authorization to Construct is valid for a period equal to that of Improvement Permit – not to exceed sixty months.

Signed: _____ date _____ Installed by: A-1 Backhoe

Improvement Permit by: _____ RS date 12-4-00 Operation Permit by: William O. Johnson date 1/18/02

Authorization to Construct by: _____ RS date 8-16-01 Existing System Inspection by: _____ date _____

HEALTH DEPT. COPY: WHITE OWNER COPY (FINAL): YELLOW OWNER COPY (INITIAL): PINK