IREDELL COUNTY HEALTH DEPARTMENT

STATESVILLE 704-878-5305 125.00 Paid MOORESVILLE 704-664-5281

IMPROVEMENT PERMIT / AUTHORIZATION TO CONSTRUCT / OPERATION PERMIT / EXISTING SYSTEM INSPECTION

PERMIT# 08952B PIN# 4713632146 (pt.) DATE Nov 8, 2000

OWNER OR CONTRACTOR Earl Garrick PHONE. Business 3749?? Home

ADDRESS 9815 J Sam Furr RR. Huntersville-

LOCATION From Trotman Old Nth Road TL Angel Oaks Dr. TR Falling Leaf Ln on Right - Corner Lot


SUBDIVISION Angel Oaks BLOCK / SECTION LOT 45 LOT AREA .87AC SITE CLASS PS DESIGN FLOW 360 gpd L.T.A.R. .25 - .3

Septic Tank: 1000 Gallons: STB 825 Date 9/27/00	☑ New System ☐ Repair System Type. I. II. III. IV. V. VI.	☐ House/Mod. Home	No. Bedrooms 3	Water Supply: ☐ Individual ☑ Public ☐ Community
Pump Tank: Gallons: PT Date	System Description: Gravity Innovative -25% Red	☐ Mobile Home	No. Bathrooms 2	
Pump Make: Model Serial No.	Repair System Description: Same	☐ Business	No. Employees	
Nitrification Field: No Fields 1 Square Feet 960 Linear Feet 320	Maintenance Agreement Required: ☐ Yes ☑ No	☐ Other		
No Lines 4@80' Trench Width 36" Max Trench Bottom Depth 36"	Gravel Depth NA	☐ Slab ☑ Crawl Space ☐ Basement w/plumbing ☐ Basement wo/plumbing		

Comments:/Conditions: R/W Angel Oaks Drive


1" = 50'

INITIAL SITE SKETCH

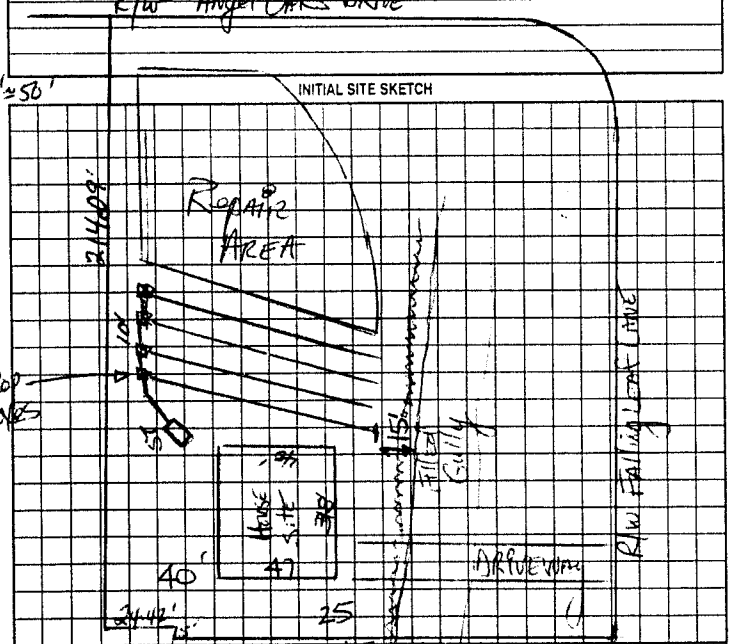

Comments:/Conditions. ① NO CUTTING OR FILLING OVER DRAINFIELD/REPAIR AREAS ② KEEP ALL DRAINS AWAY FROM DRAINFIELD/REPAIR AREAS ③ PUMP SEPTIC TANK EVERY 3-5 YRS.

~~AS BUILT SKETCH~~

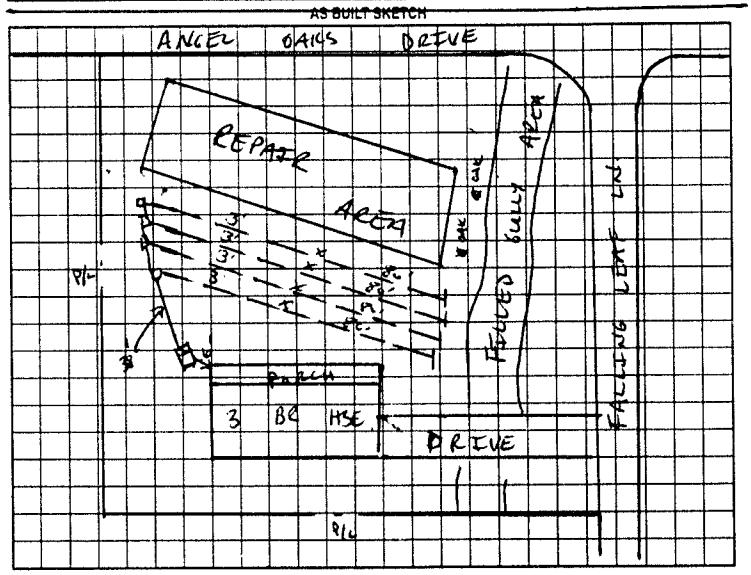

Permit can be suspended or revoked if any false information is supplied toward securing the permit/any unauthorized changes are made to the site/any unauthorized changes are made in the installation of the system. Improvement Permit with plat valid without expiration. Improvement Permit with site plan valid for sixty months. Authorization to Construct is valid for a period equal to that of Improvement Permit – not to exceed sixty months.

Signed: date 11-9-00 Installed by: STATESVILLE BACHOE

Improvement Permit by: date 11-8-00 Operation Permit by: date 2/27/01

Authorization to Construct by: STEVE HEDRICK date 1-12-01 Existing System Inspection by: date

HEALTH DEPT COPY WHITE OWNER COPY (FINAL): YELLOW OWNER COPY (INITIAL) PINK