IREDELL COUNTY HEALTH DEPARTMENT

STATESVILLE 704-878-5305 ✓ MOORESVILLE 704-664-5281

IMPROVEMENT PERMIT / AUTHORIZATION TO CONSTRUCT / OPERATION PERMIT / EXISTING SYSTEM INSPECTION

PERMIT# 089287 PIN# 4713632148 (pt) DATE Jan 22, 01

OWNER OR CONTRACTOR EARL GARRICK PHONE: Business 374-9700 Home

ADDRESS 9815 J Sam Furr Rd Huntersville N.C. 28078

LOCATION From Trantman Old NC 150 TL Angel Oaks DR. on left

SUBDIVISION Angel Oaks BLOCK / SECTION LOT 5 LOT AREA .86 SITE CLASS 1F DESIGN FLOW 360 gpd L.T.A.R. .3

Septic Tank: 1000 Gallons: STB 1012 Date 10-1-01
Pump Tank: Gallons: PT Date
Pump Make: Model Serial No
Nitrification Field: No Fields 1 Square Feet 900 Linear Feet 300
No Lines 5 Trench Width 36 Trench Bottom Depth 36" Gravel Depth NA

✓ New System ☐ Repair System Type: I, II, III, IV, V, VI
System Description: Presby Innovative - 25% Red
Repair System Description: Same
Maintenance Agreement Required: ☐ Yes ✓ No
☐ Slab ✓ Crawl Space ☐ Basement w/plumbing ☐ Basement wo/plumbing

✓ House/Mod. Home No. Bedrooms 3
☐ Mobile Home No. Bathrooms 2
☐ Business No. Employees
☐ Other

Water Supply: ☐ Individual ☒ Public ☐ Community

10/15/01

Comments/Conditions: 160'


54

INSTALL LATERALS AT 36" trench bottom depth.
USE Drop Box / SERIAL Distribution

Comments/Conditions: (House 34' x 38' to be built as per Initial Site Sketch 40'x24')
- Septic Tank Risers & Poly Lok Filter Installed


INITIAL SITE SKETCH

1" = 50'

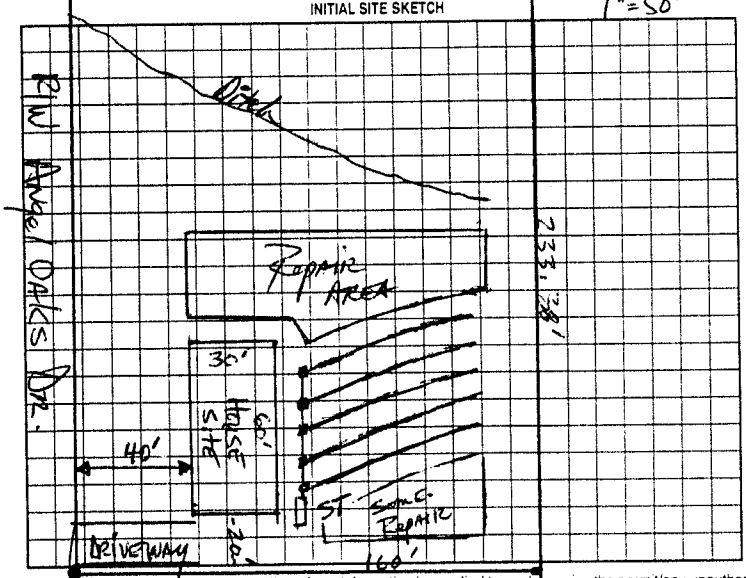

AS BUILT SKETCH

1" = 60'

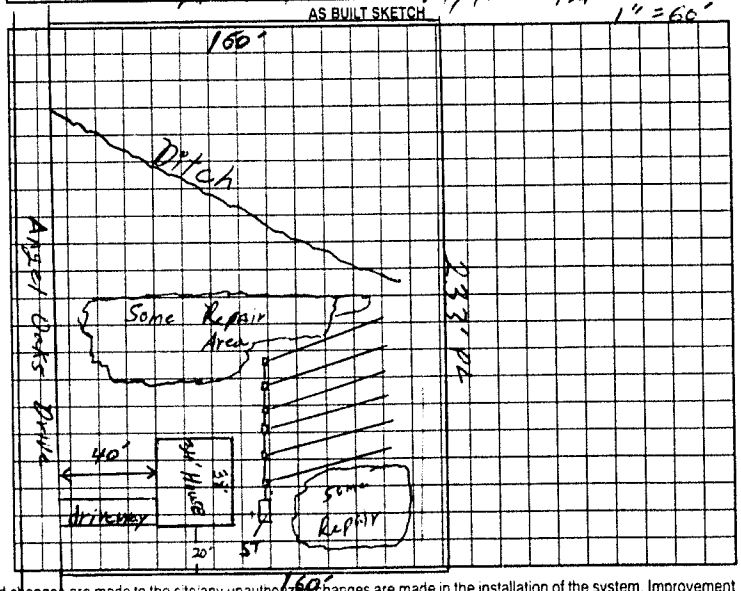

Permit can be suspended or revoked if any false information is supplied toward securing the permit/any unauthorized changes are made to the site/any unauthorized changes are made in the installation of the system. Improvement Permit with plat valid without expiration. Improvement Permit with site plan valid for sixty months. Authorization to Construct is valid for a period equal to that of Improvement Permit – not to exceed sixty months.

Signed: date

Improvement Permit by: date Jan 22, 01

Authorization to Construct by: William C. Johnson date 10/15/01

Installed by: A-1 Backhoe

Operation Permit by: William C. Johnson date 12/4/01

Existing System Inspection by: date

HEALTH DEPT COPY WHITE OWNER COPY (FINAL) YELLOW OWNER COPY (INITIAL) PINK