IREDELL COUNTY HEALTH DEPARTMENT - *ENVIRONMENTAL HEALTH* ☑ STATESVILLE OFFICE 704-878-5305 ☐ MOORESVILLE OFFICE 704-664-5281

IMPROVEMENT PERMIT / AUTHORIZATION TO CONSTRUCT / OPERATION PERMIT / EXISTING SYSTEM INSPECTION ②

PERMIT # 163365 PIN # 4713-63-7304 DATE 11-3-10

OWNER Rita Taggert APPLICANT: PHONE: Home/Cell # 704-878-0558 Business #

SITE ADDRESS 145 Angel Oaks Drive OWNER / APPLICANT ADDRESS

SITE DIRECTIONS

SUBDIVISION Angel Oaks BLOCK / SECTION LOT # 5 LOT AREA .86 DESIGN FLOW existing L.T.A.R. existing

Septic Tank existing Gallons: STB Date
Pump Tank Gallons: P T Date
Pump Make Model Serial #
No. Nitrification Fields: 1 No. Lines 6 Linear Feet 300
Trench Width 36" Max. Trench Bottom Depth 36"


☐ New System ☐ Repair ☐ Expansion System Type I II ⓘ IV V VI
System Description: existing
Repair System Description:
Maintenance Agreement Required ☐ YES ☒ NO
Gravel Depth n/a ☒ GRAVITY ☐ PRESSURE

☒ Residence No. Bedrooms 3
☐ Business No. Persons
☐ Other No. Employees
☐ Slab ☒ Crawl Space
☐ Basement w/plumbing ☐ Basement w/o plumbing


Water Supply
☐ Private
☒ Public
☐ Community

Comments / Conditions

INITIAL SITE SKETCH

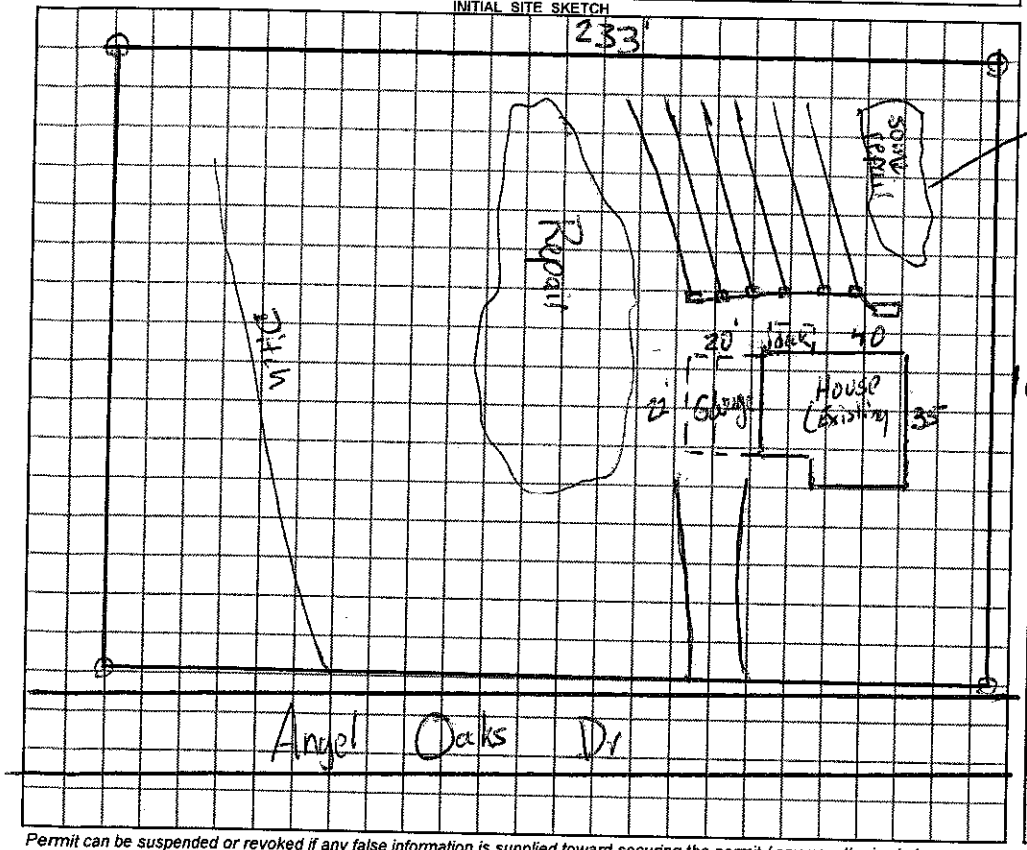

AS BUILT SKETCH

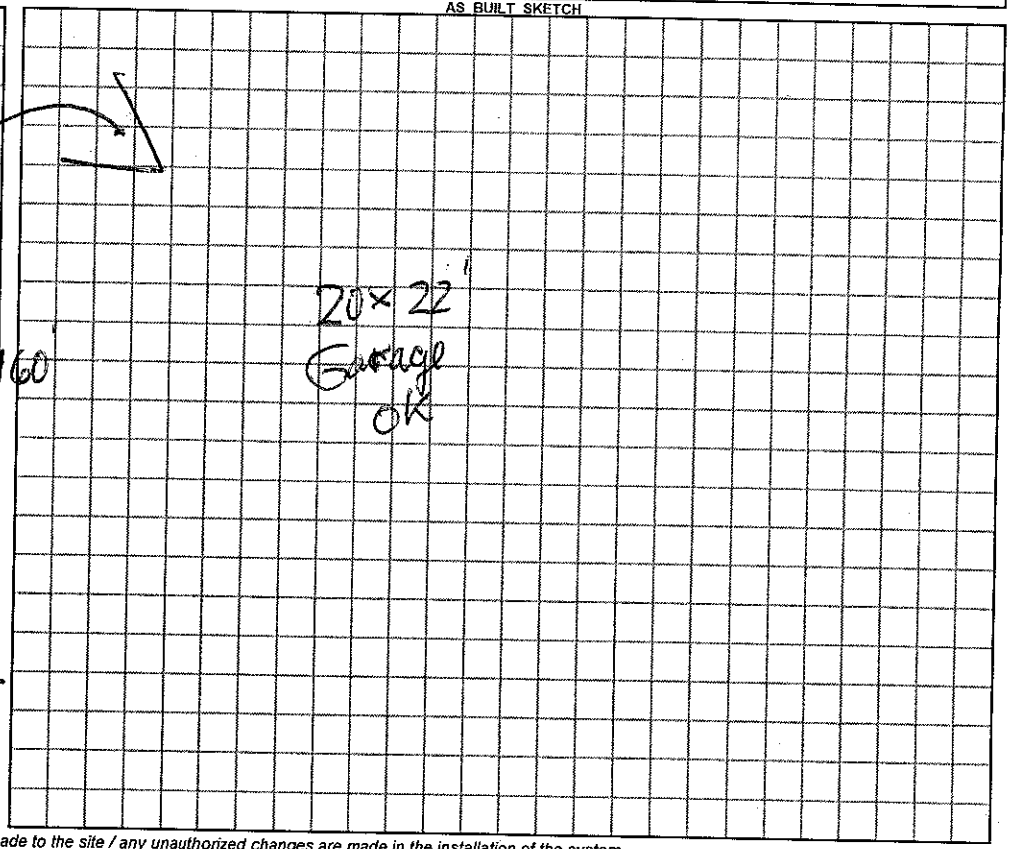

Permit can be suspended or revoked if any false information is supplied toward securing the permit / any unauthorized changes are made to the site / any unauthorized changes are made in the installation of the system.

☐ ***IMPROVEMENT PERMIT*** *with plat valid without expiration.* ☐ ***IMPROVEMENT PERMIT*** *with plat valid without expiration.* ☐ ***AUTHORIZATION TO CONSTRUCT*** valid for period equal to IMPROVEMENT PERMIT--not to exceed 60 mo.

Owner / Applicant Signature: Rita Taggert Date

IMPROVEMENT PERMIT by: REHS Date

AUTHORIZATION TO CONSTRUCT by: REHS Date

YOU SHOULD CONTACT A LOCATOR SERVICE PRIOR TO ANY EXCAVATION

Installed by:

OPERATION PERMIT by: REHS Date

Existing System Inspected by: REHS Date 11-3-10

White Copy – Environmental Health YELLOW COPY (Final) Owner / Applicant PINK COPY (Initial) Owner / Applicant