IREDELL COUNTY HEALTH DEPARTMENT

STATESVILLE 704-878-5305 125.00 Paid MOORESVILLE 704-664-5281

IMPROVEMENT PERMIT / AUTHORIZATION TO CONSTRUCT / OPERATION PERMIT / EXISTING SYSTEM INSPECTION

PERMIT# 08927 PIN# 4713632148 (GT) DATE Nov. 6, 00

OWNER OR CONTRACTOR Earl Garrick PHONE: Business 374-9700 Home

ADDRESS 9815 J Sam Furr Rd. Huntersville 28078

LOCATION From Traditions - 958 NTN Road TL Angel Oaks Dr. 3rd lot on left

SUBDIVISION Angel Oaks BLOCK / SECTION LOT 3 LOT AREA 140'x160' SITE CLASS. PS DESIGN FLOW 360 gpd L.T.A.R. .3-.25

Septic Tank: 1000 Gallons; STB 825 Date 2/6/01
Pump Tank: 1000 Gallons; PT 302 Date 1/9/01
Pump Make: Little Giant Model 9EH-CIM Serial No. 509330
Nitrification Field: No Fields 1 Square Feet 1080 Linear Feet 360
No Lines 4@90' Trench Width 36" Trench Bottom Depth 36"

☑ New System ☐ Repair System Type: I, II, III, IV, V, VI
System Description: Pm Innovative -25% Red.
Repair System Description: LP Panel Block
Maintenance Agreement Required: ☐ Yes ☑ No
Gravel Depth NA ☐ Slab ☑ Crawl Space ☐ Basement w/plumbing ☐ Basement wo/plumbing


☑ House/Mod. Home No. Bedrooms 3
☐ Mobile Home No. Bathrooms 3
☐ Business No. Employees
☐ Other

Water Supply: ☐ Individual ☑ Public ☐ Community


Comments/Conditions: Install Laterals at 36" trench bottom depths

Comments/Conditions: ① Pump septic tank every 3-5 yrs.
3/19/01 - checked drainlines and set head
- still needs electrical

INITIAL SITE SKETCH

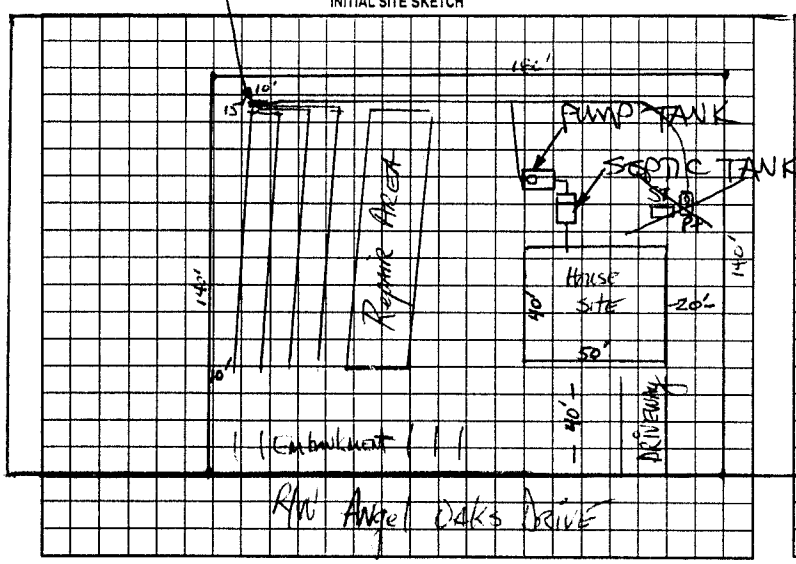

AS BUILT SKETCH

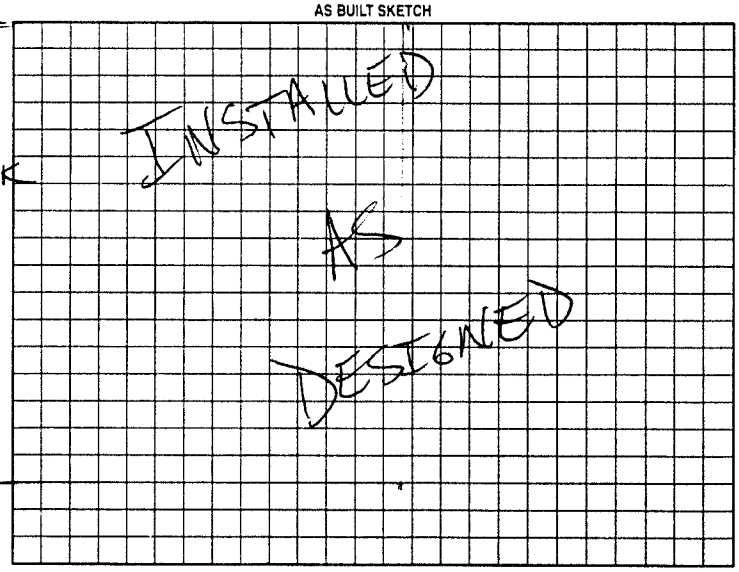

Permit can be suspended or revoked if any false information is supplied toward securing the permit/any unauthorized changes are made to the site/any unauthorized changes are made in the installation of the system. Improvement Permit with plat valid without expiration. Improvement Permit with site plan valid for sixty months. Authorization to Construct is valid for a period equal to that of Improvement Permit – not to exceed sixty months.

Signed: AO date 11-9-00

Improvement Permit by: [signature] date 11-8-00

Authorization to Construct by: STEVE HEARICK date 1-12-01

Installed by: STATESVILLE BACKHOE

Operation Permit by: STEVE HEARICK date 6-1-01

Existing System Inspection by: date

HEALTH DEPT. COPY: WHITE OWNER COPY (FINAL): YELLOW OWNER COPY (INITIAL): PINK