Permit 159183 attached for sunroom addition 12/10/09. 3.5" TOPSOIL FILL

# IREDELL COUNTY HEALTH DEPARTMENT

STATESVILLE 704-878-5305 (W) MOORESVILLE 704-664-5281

## IMPROVEMENT PERMIT / AUTHORIZATION TO CONSTRUCT / OPERATION PERMIT / EXISTING SYSTEM INSPECTION

PERMIT# 138425 PIN# 4713641046 DATE 2-12-07

OWNER OR APPLICANT Angel OAKS DUPONT PHONE: Business 704-948-6466 Home

ADDRESS 9815 J SAM FURR RD SUITE 221 HUNTERSVILLE NC 28078

LOCATION 40 WEST @ OLD MOUNTAIN RD @ Angel OAKS @ LEFT ON PT AT END

SUBDIVISION Angel OAKS BLOCK / SECTION LOT 43 LOT AREA 174,135 SITE CLASS. PS DESIGN FLOW 360 L.T.A.R. .3

Septic Tank: 1000 Gallons; STB 5-2707 Date 7-14-07

Pump Tank: 1500 Gallons; PT 373 Date 5-14-07

Pump Make: GOULDS Model WE1512HH1 Serial No.

Nitrification Field: No Fields 1 Square Feet 60-120' Linear Feet 300'

No Lines 4/5' Trench Width 36" Max Trench Bottom Depth 36" Gravel Depth N/A ☐ Gravity ☒ Pressure

☒ New System ☐ Repair ☐ Expansion System Type: I II III IV V VI

System Description: PUMP 250/0 REDUCTION

Repair System Description: LP 50% REDUCTION

Maintenance Agreement Required: ☐ Yes ☒ No

☒ House/Mod. Home ☐ Mobile Home ☐ Business ☐ Other

No. Bedrooms 3 No. Persons 6 No. Employees

Water Supply: ☐ Individual ☒ Public ☐ Community

☐ Slab ☒ Crawl Space ☐ Basement w/plumbing ☐ Basement wo/plumbing

Comments:/Conditions: ① INSTALL LINES ON CONTOURS ② MAINTAIN SETBACKS ③ SYSTEM COMPLETELY FLAGGED


Comments:/Conditions: DOUBLE Filter TRENCHES AT MONITOR SY

V.O LINES THAT ONLY BE PLANT LINES HAD TO FALL DOWN FOR ALLOWABLE BY RULES

INITIAL SITE SKETCH

SEE ATTACHED SYSTEM DESIGN BY LORNE COOK R.S.

AS BUILT SKETCH LC 6/20/07

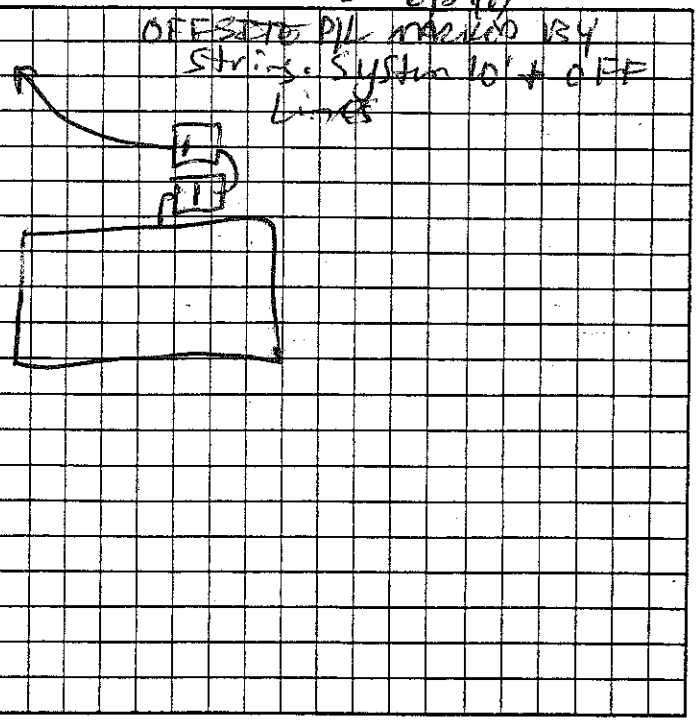



Permit can be suspended or revoked if any false information is supplied toward securing the permit/any unauthorized changes are made to the site/any unauthorized changes are made in the installation of the system. Improvement Permit with plat valid without expiration ☐ Improvement Permit with site plan valid for sixty months ☒ Authorization to Construct is valid for a period equal to that of Improvement Permit – not to exceed sixty months.

Signed: date 2/13/07 Installed by: MARTY TOLLEY

Improvement Permit by: date 2-12-07 Operation Permit by: date 8/6/08

Authorization to Construct by: date 2-12-07 Existing System Inspection by: date


HEALTH DEPT. COPY: WHITE OWNER COPY (FINAL): YELLOW OWNER COPY (INITIAL): PINK

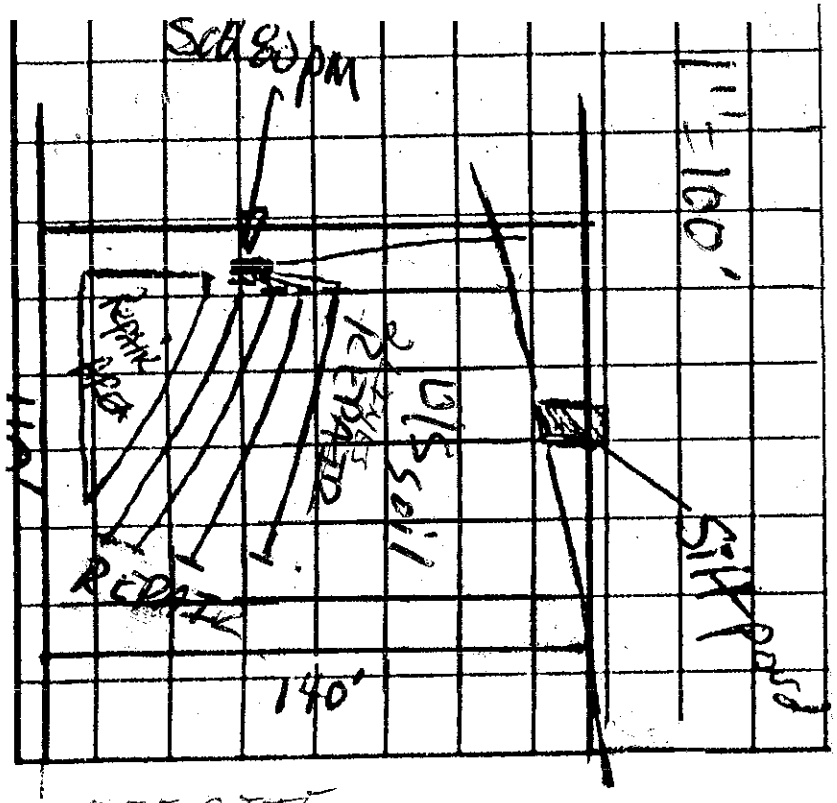


OFF SITE

① INSTALL 4 LINES x 75' LONG
25% REDUCTION

② System is FLAGGED completely

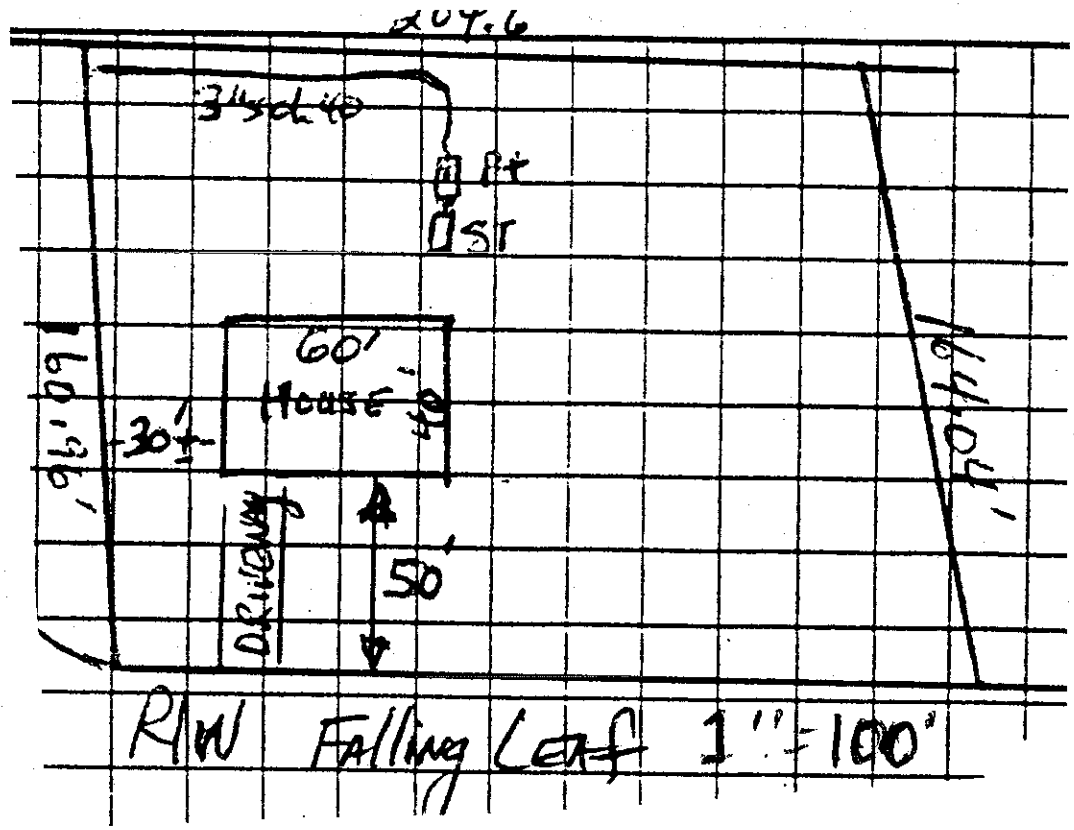


Initial LOT

PERMIT # 132425

PIN # 4713641046