3.5" TETHER FLAT

IREDELL COUNTY HEALTH DEPARTMENT

STATESVILLE 704-878-5305 MOORESVILLE 704-664-5281

IMPROVEMENT PERMIT / AUTHORIZATION TO CONSTRUCT / OPERATION PERMIT / EXISTING SYSTEM INSPECTION

PERMIT# 138425 PIN# 4713641046 DATE 2-12-07

OWNER OR APPLICANT Angel OAKS DUPLEX

ADDRESS 9815 J SANFORD SUITE 221 HUNTERSVILLE NC 28078 PHONE: Business 704-948-6466 Home

LOCATION 40 WEST @ OLD MTN RD @ Angel OAKS @ LAUREL LEAF ON RT AT END

SUBDIVISION Angel OAKS BLOCK / SECTION LOT 43 LOT AREA 174,135 SITE CLASS. PS DESIGN FLOW 360 L.T.A.R. .3

Septic Tank: 1000 Gallons; STB S-2707 Date 7/24

Pump Tank: 1000 Gallons; PT 273 Date 5-14-07

Pump Make: GOULDS Model VE 1512 HH1 Serial No.

Nitrification Field: No Fields 1 Square Feet 60-120' Linear Feet 300'

No Lines 4 @ 75' Trench Width 36" Max Trench Bottom Depth 36" Gravel Depth N/A ☐ Gravity ☒ Pressure

☒ New System ☐ Repair ☐ Expansion System Type: I II III IV V VI

System Description: PUMP 25% REDUCTION

Repair System Description: LP 50% REDUCTION

Maintenance Agreement Required: ☐ Yes ☒ No

☒ House/Mod. Home ☐ Mobile Home ☐ Business ☐ Other

No. Bedrooms 3 No. Persons 6 No. Employees

Water Supply: ☐ Individual ☒ Public ☐ Community

☐ Slab ☒ Crawl Space ☐ Basement w/plumbing ☐ Basement wo/plumbing

Comments:/Conditions: (1) INSTALL LINES ON CONTOURS & MAINTAIN SETBACK (2) SYSTEM COMPLETELY FLAGGED


Comments:/Conditions: POLICAL FILTER ADJACENT TO MOORE ST

V.O LINES THAT ONLY BE PLANTED LINES HAD ¼" FALL PER FOOT ALLOWABLE BY RULES

INITIAL SITE SKETCH

SEE ATTACHED SYSTEM DESIGN BY LOUIE LOCK R.S.

AS BUILT SKETCH LL 6/29/07

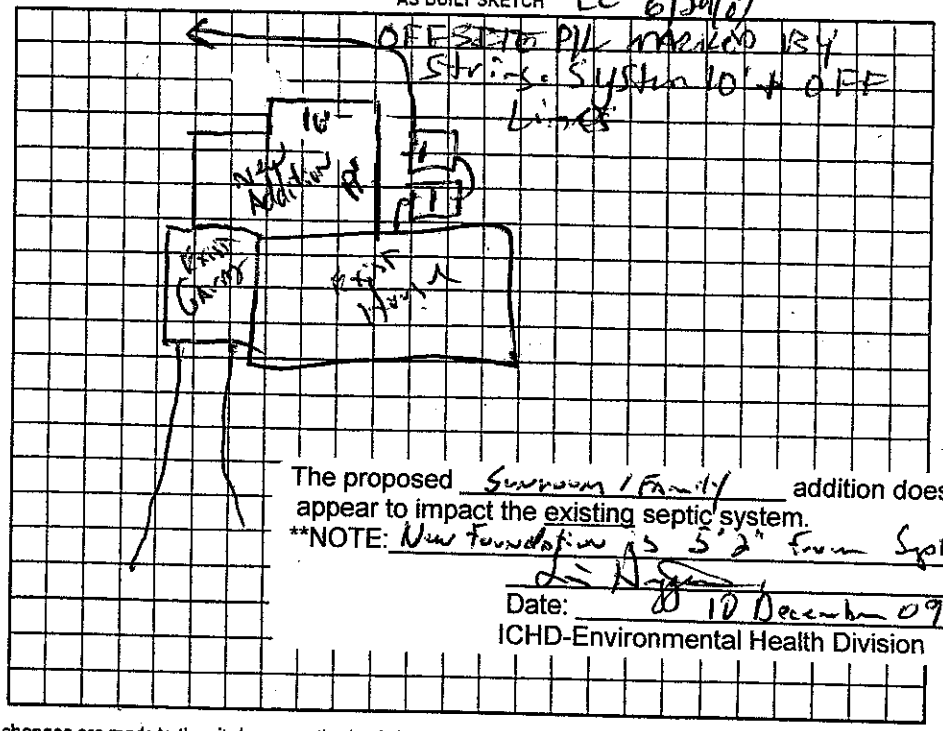

The proposed Sunroom / Family addition does not appear to impact the existing septic system.

**NOTE: New Foundation is 5'2" from Septic System

R.S.

Date: 10 December 09

ICHD-Environmental Health Division

Permit can be suspended or revoked if any false information is supplied toward securing the permit/any unauthorized changes are made to the site/any unauthorized changes are made in the installation of the system. Improvement Permit with plat valid without expiration ☐ Improvement Permit with site plan valid for sixty months ☒ Authorization to Construct is valid for a period equal to that of Improvement Permit – not to exceed sixty months.

Signed: date 2/13/07

Improvement Permit by: date 2-12-07

Authorization to Construct by: date 2-13-07

Installed by: MARTY TOLLEE

Operation Permit by: date 8/6/08

Existing System Inspection by: date

HEALTH DEPT. COPY: WHITE OWNER COPY (FINAL): YELLOW OWNER COPY (INITIAL): PINK