IREDELL COUNTY HEALTH DEPARTMENT

STATESVILLE 704-878-5305 — MOORESVILLE 704-664-5281

IMPROVEMENT PERMIT / AUTHORIZATION TO CONSTRUCT / OPERATION PERMIT / EXISTING SYSTEM INSPECTION

PERMIT# 089329 PIN# 4713632148 (pt) DATE October 19, 00

OWNER OR CONTRACTOR Earl Garrick // Prestige Bld. Co Inc. PHONE: Business 374-9700 // 528-3949 Home

ADDRESS 9845 J Sam Furr Rd. Huntersville N.C. 28078 // 107 Barkdale Rd. Troutman NC 28166

LOCATION From Troutman Old Mtn Rd. TL Angel Oaks Dr. 3rd Lt on Right

SUBDIVISION Angel Oaks BLOCK / SECTION LOT 46 LOT AREA 100 X 214 SITE CLASS IS DESIGN FLOW 360 gpd L.T.A.R. .3 - (front yard)

Septic Tank: 1000 Gallons; STB 1012 Date 9-2000
Pump Tank: Gallons; PT Date
Pump Make: Model Serial No.
Nitrification Field: No Fields 1 Square Feet 1200 Linear Feet 400
No Lines 4@100' Trench Width 36" Max Trench Bottom Depth 36"

☑ New System ☐ Repair System Type: I, II, III, IV, V, VI
System Description: GRAVITY CONVENTIONAL
Repair System Description: SAME
Maintenance Agreement Required: ☐ Yes ☑ No
Gravel Depth 12"


☑ House/Mod. Home ☐ Mobile Home ☐ Business ☐ Other
No. Bedrooms 3 No. Bathrooms 2 No. Employees
☐ Slab ☑ Crawl Space ☐ Basement w/plumbing ☐ Basement wo/plumbing

Water Supply: ☐ Individual ☑ Public ☐ Community

Comments/Conditions: 10-25-00 Revised Floor plan & Recd App. All appears in compliance w/ I.P.


Comments/Conditions: SEPTIC TANK WITH RISERS INSTALLED USING "POLYLOK" FILTER

INITIAL SITE SKETCH 1" = 40'

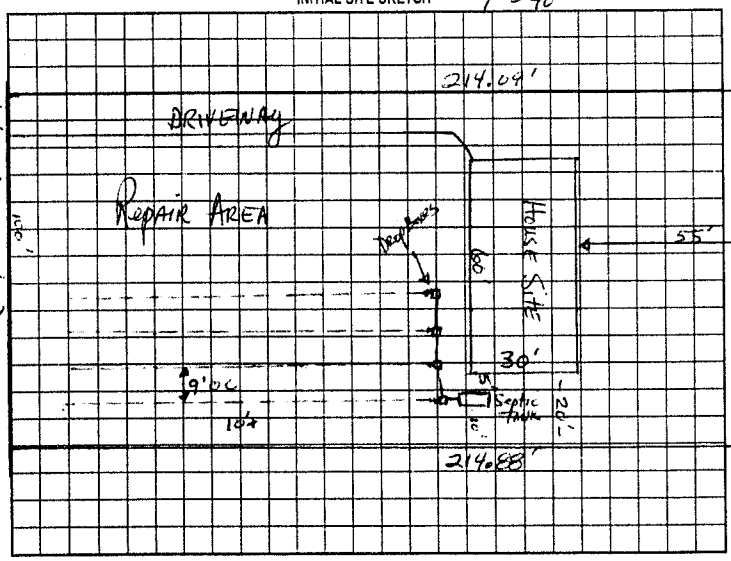

RW Angel Oaks Drive

AS BUILT SKETCH

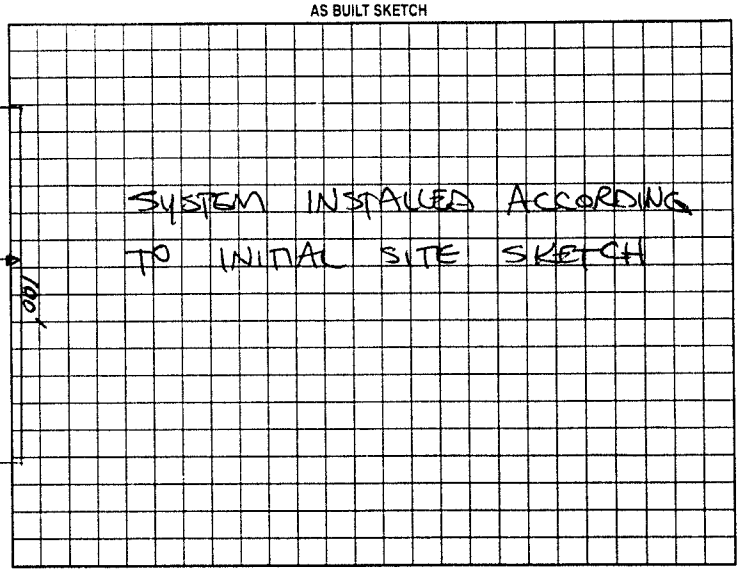

Permit can be suspended or revoked if any false information is supplied toward securing the permit/any unauthorized changes are made to the site/any unauthorized changes are made in the installation of the system. Improvement Permit with plat valid without expiration. Improvement Permit with site plan valid for sixty months. Authorization to Construct is valid for a period equal to that of Improvement Permit – not to exceed sixty months.

Signed: * date

Improvement Permit by: date 10-19-00

Authorization to Construct by: date 10-25-00

Installed by: STATESVILLE BACKHOE

Operation Permit by: STEVE HEDRICK date 11-16-00

Existing System Inspection by: date

HEALTH DEPT COPY: WHITE OWNER COPY (FINAL): YELLOW OWNER COPY (INITIAL): PINK