IREDELL COUNTY HEALTH DEPARTMENT

THIS PERMIT VOIDS PREVIOUS ISSUED 11-8-00

STATESVILLE 704-878-5305 MOORESVILLE 704-664-5281

IMPROVEMENT PERMIT / AUTHORIZATION TO CONSTRUCT / OPERATION PERMIT / EXISTING SYSTEM INSPECTION

PERMIT# 090172 PIN# 4713 63 2148 (PART) DATE 2-7-01

OWNER OR CONTRACTOR EARL GARRICK PHONE: Business (704) 374-9700 Home

ADDRESS 9815 J. SAM FURR ROAD, HUNTERSVILLE, NC 28078

LOCATION I-40 W, TL OLD MOUNTAIN RD, TR ANGEL OAKS DRIVE, 2ND LOT ON RIGHT

SUBDIVISION ANGEL OAKS BLOCK / SECTION LOT 47 LOT AREA 0.49 ACRE SITE CLASS P'S DESIGN FLOW 360 L.T.A.R. 0.30 GPD/FT²

Septic Tank: 1000 Gallons; STB 1012 Date 11-18-00
Pump Tank: Gallons; PT Date
Pump Make: Model Serial No
Nitrification Field: No Fields 1 Square Feet 1200 Linear Feet 400
No Lines FOUR Trench Width 36" Max Trench Bottom Depth 36" Gravel Depth 12"

☑ New System ☐ Repair System Type: I II III IV V VI
System Description: CONVENTIONAL GRAVITY
Repair System Description: 50% REDUCTION, PUMP
Maintenance Agreement Required: ☐ Yes ☑ No
☐ Slab ☑ Crawl Space ☐ Basement w/plumbing ☐ Basement wo/plumbing


☑ House/Mod. Home No. Bedrooms 3
☐ Mobile Home No. Bathrooms 2
☐ Business No. Employees
☐ Other

Water Supply: ☐ Individual ☑ Public ☐ Community


Comments/Conditions: ① KEEP SYSTEM & REPAIR MINIMUM TEN (10) FEET FROM WATER LINE, FIFTEEN (15) FEET FROM DITCH EMBANKMENT ② NO VEHICULAR TRAFFIC ALLOWED OVER SYSTEM

Comments/Conditions: SEPTIC TANK W/ RISERS INSTALLED USING "POLYLOK" FILTER

INITIAL SITE SKETCH SCALE: 1"=40'

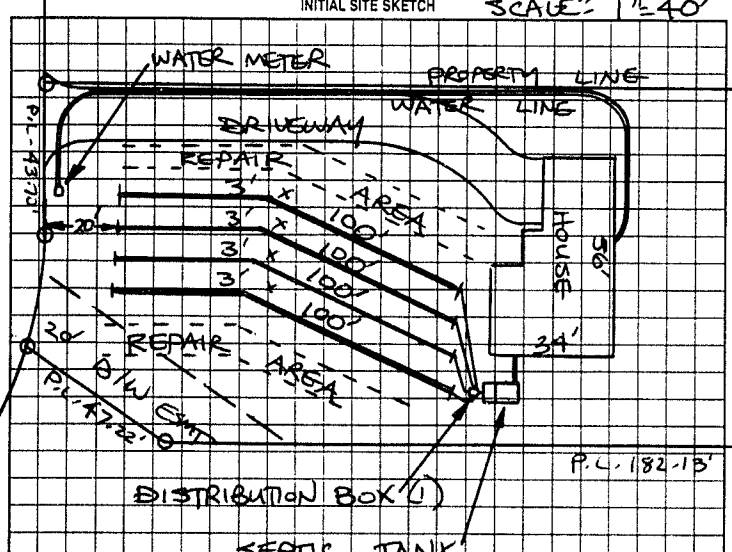

AS BUILT SKETCH

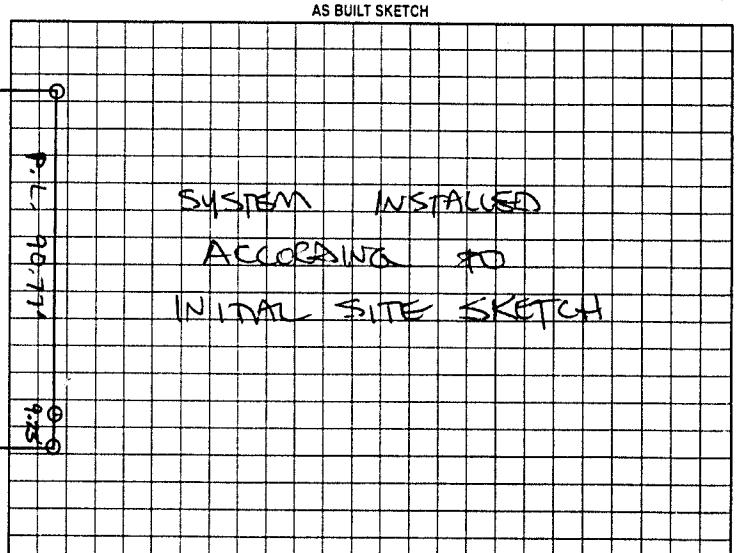

Permit can be suspended or revoked if any false information is supplied toward securing the permit/any unauthorized changes are made to the site/any unauthorized changes are made in the installation of the system. Improvement Permit with plat valid without expiration. Improvement Permit with site plan valid for sixty months. Authorization to Construct is valid for a period equal to that of Improvement Permit - not to exceed sixty months.

Signed: Michael Stapleton date 2/6/01 Installed by: STATESVILLE BACKHOE SERVICE

Improvement Permit by: STEVE HEDRICK date 2-7-01 Operation Permit by: STEVE HEDRICK date 2-9-01

Authorization to Construct by: STEVE HEDRICK date 2-7-01 Existing System Inspection by: date

HEALTH DEPT. COPY. WHITE OWNER COPY (FINAL) YELLOW OWNER COPY (INITIAL) PINK