IREDELL COUNTY HEALTH DEPARTMENT

STATESVILLE 704-878-5305 MOORESVILLE 704-664-5281

IMPROVEMENT PERMIT / AUTHORIZATION TO CONSTRUCT / OPERATION PERMIT / EXISTING SYSTEM INSPECTION

PERMIT# 13826 PIN# 4713645363 DATE 12-14-07

OWNER OR APPLICANT Premier Developers PHONE: Business 704-948-6466 Home

ADDRESS 9815 J. SAM FURR Rd SUITE 231 Huntersville, NC 28078

LOCATION 21 SOUTH (R) ONE (L) Angel OAKS Immediately on Rt

SUBDIVISION Angel OAKS BLOCK / SECTION LOT 48 LOT AREA .49 SITE CLASS. PS DESIGN FLOW 360 L.T.A.R. .3

Septic Tank: 1000 Gallons: STB 764 Date 6.11.07
Pump Tank: Gallons: PT Date
Pump Make: Model Serial No.
Nitrification Field: No Fields 1 Square Feet EQ=1200' Linear Feet 200'
No Lines 4x50' Trench Width 24" Max Trench Bottom Depth 36" Gravel Depth N/A

☒ New System ☐ Repair ☐ Expansion System Type: I II (III) IV V VI
System Description: GRAVITY 50% REDUCTION
Repair System Description: LP 50% REDUCTION
Maintenance Agreement Required: ☐ Yes ☒ No

☒ House/Mod. Home No. Bedrooms 3
☐ Mobile Home No. Persons 6
☐ Business No. Employees
☐ Other

Water Supply: ☐ Individual ☒ Public ☐ Community

☒ Gravity ☐ Pressure ☐ Slab ☒ Crawl Space ☐ Basement w/plumbing ☐ Basement wo/plumbing

Comments/Conditions: ① BUILDER MET ME & WENT OVER L/D. SEE ATTACHED COMMENTS THATS ON THE PERMIT SKETCH. ② IF COMMENTS ARE NOT FOLLOWED PERMIT WILL BE VOID & LOW PRESSURE MAY BE ONLY OPTION.

INITIAL SITE SKETCH

SEE ATTACHED SYSTEM DESIGN BY LORIE COOK, R.S.

Comments/Conditions: 9" = FALL ON Supply is 50'
DRIVE FILL + MARKER
CHAMBER SYSTEM ORDERED 2 FLOW DIVIDER TEE & 2 DIST. BOX'S WITH SPEED LEVELERS TO 4

AS BUILT SKETCH

DIST. BOX WITH SPEED SO WE COULD KEEP EQUAL FALL FROM THE TANK.
OK'D By Kristy
4-14-09
SIGNATURE

Permit can be suspended or revoked if any false information is supplied toward securing the permit/any unauthorized changes are made to the site/any unauthorized changes are made in the installation of the system. Improvement Permit with plat valid without expiration ☐ Improvement Permit with site plan valid for sixty months ☒ Authorization to Construct is valid for a period equal to that of Improvement Permit – not to exceed sixty months.


Signed: date 2/19/07 Installed by: MARK TAYLOR GRADING

Improvement Permit by: date 12-14-07 Operation Permit by: date 10-27-08

Authorization to Construct by: date 12-14-07 Existing System Inspection by: date

HEALTH DEPT. COPY: WHITE OWNER COPY (FINAL): YELLOW OWNER COPY (INITIAL): PINK

PERMIT # 158426
PIN # 4713645363

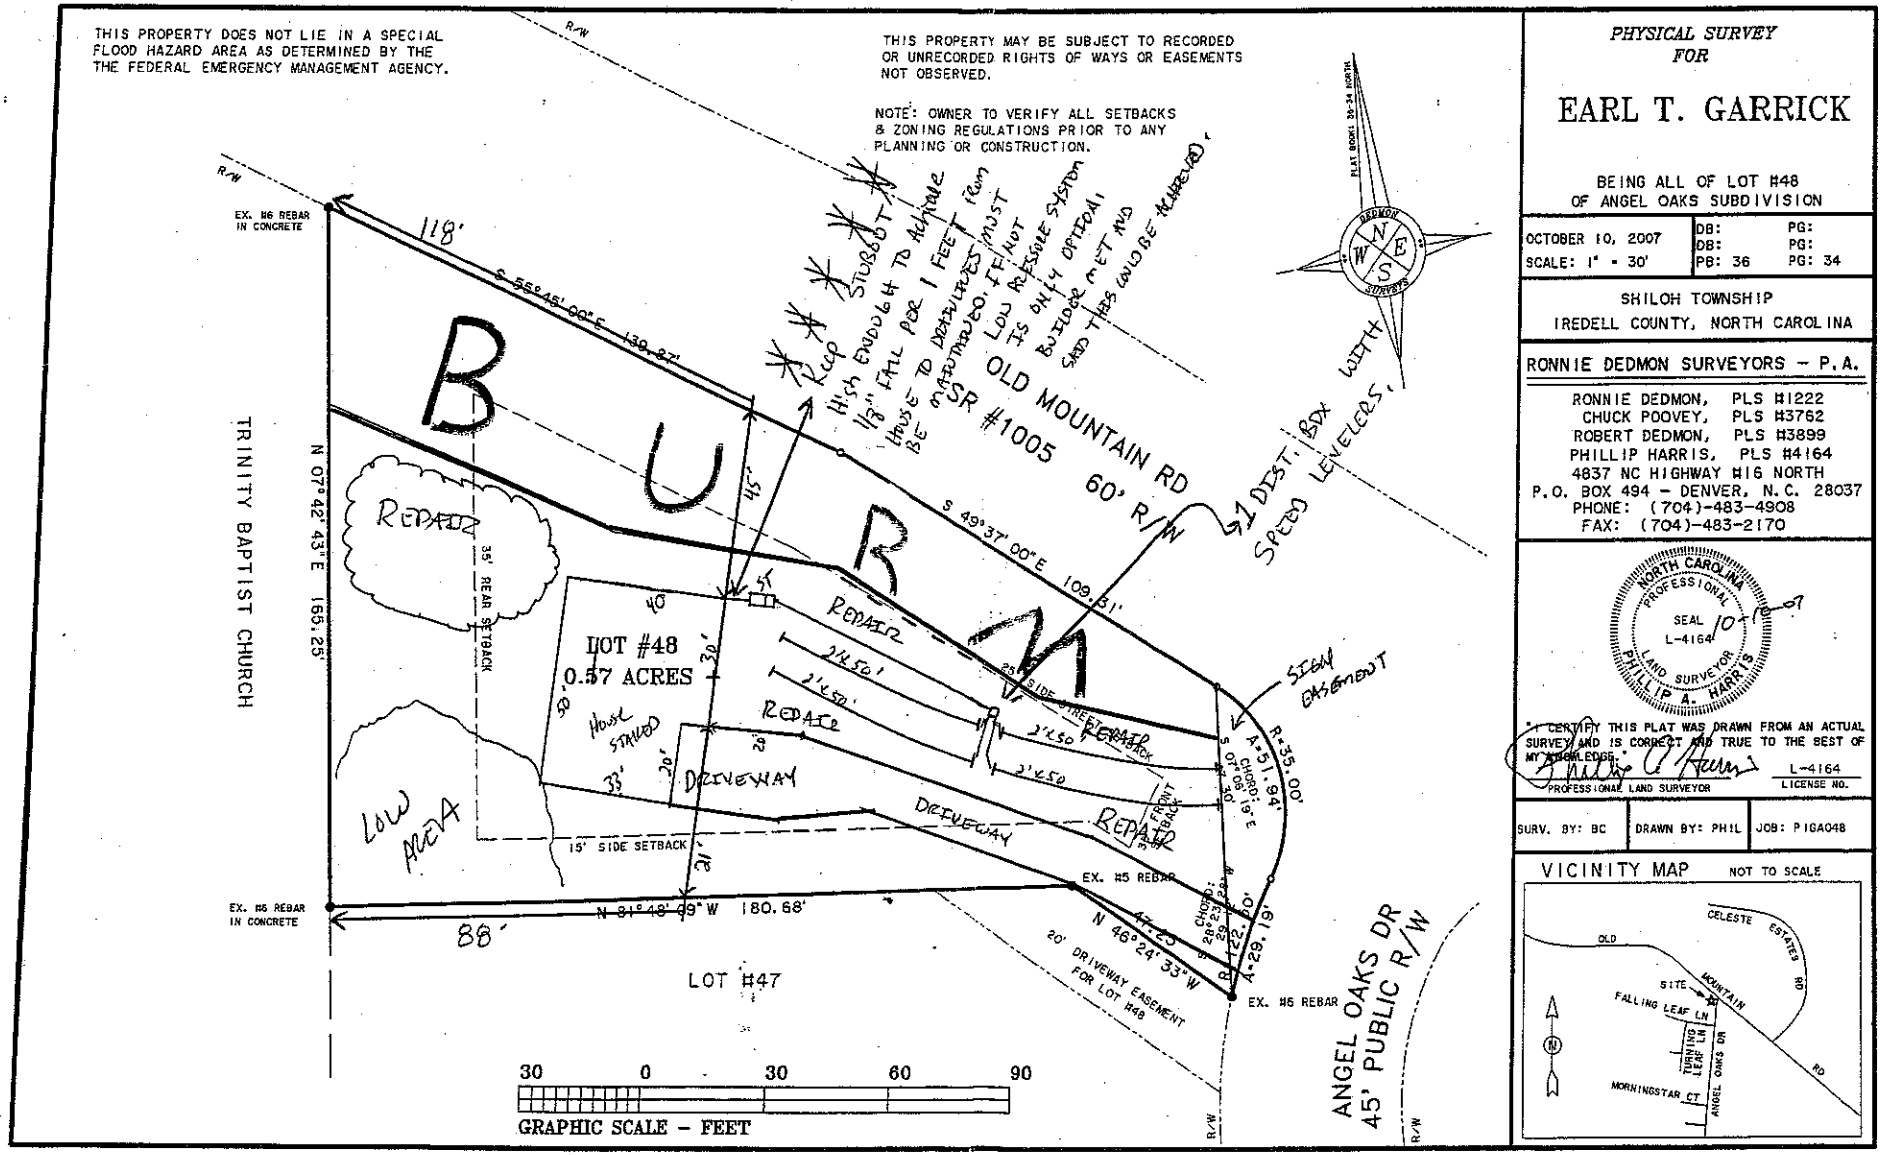

PHYSICAL SURVEY FOR

EARL T. GARRICK

BEING ALL OF LOT #48
OF ANGEL OAKS SUBDIVISION

OCTOBER 10, 2007	DB:	PG:
SCALE: 1" = 30'	DB:	PG:
	PB: 36	PG: 34

SHILOH TOWNSHIP
IREDELL COUNTY, NORTH CAROLINA

RONNIE DEDMON SURVEYORS - P.A.

RONNIE DEDMON, PLS #1222
CHUCK POOVEY, PLS #3762
ROBERT DEDMON, PLS #3899
PHILLIP HARRIS, PLS #4164
4837 NC HIGHWAY #16 NORTH
P.O. BOX 494 - DENVER, N.C. 28037
PHONE: (704)-483-4908
FAX: (704)-483-2170

NORTH CAROLINA PROFESSIONAL SEAL L-4164 LAND SURVEYOR PHILLIP A. HARRIS

"I CERTIFY THIS PLAT WAS DRAWN FROM AN ACTUAL SURVEY AND IS CORRECT AND TRUE TO THE BEST OF MY KNOWLEDGE."

PROFESSIONAL LAND SURVEYOR — L-4164 LICENSE NO.

SURV. BY: BC	DRAWN BY: PHIL	JOB: P1GA048

VICINITY MAP NOT TO SCALE