IREDELL COUNTY HEALTH DEPARTMENT

STATESVILLE 704-878-5305 (C1) MOORESVILLE 704-664-5281

IMPROVEMENT PERMIT / AUTHORIZATION TO CONSTRUCT / OPERATION PERMIT / EXISTING SYSTEM INSPECTION

PERMIT# 115574 PIN# 4713-66-9727 DATE 9-18-03

OWNER OR CONTRACTOR MARVIN STEWART PHONE: Business _____ Home 704-872-8451

ADDRESS 492 BETHLEHEM ROAD STATESVILLE NC 28677

LOCATION US 70 WEST, TL BETHLEHEM ROAD, 4TH LOT ON RIGHT PAST HAPPY LANE

SUBDIVISION MTN. RD. VILLAGE BLOCK / SECTION _____ LOT 18 LOT AREA 0.56 ACRES SITE CLASS. P5 DESIGN FLOW 360 L.T.A.R. EXISTING

Septic Tank: EXISTING Gallons; STB _____ Date _____

Pump Tank: _____ Gallons; PT _____ Date _____

Pump Make: _____ Model _____ Serial No. _____

Nitrification Field: No Fields 1 Square Feet 240 Linear Feet 80

No Lines 1 Trench Width 36" Max Trench Bottom Depth 36"

☐ New System ☑ Repair System Type: I, II, III, IV, V, VI

System Description: CONVENTIONAL, GRAVITY

Repair System Description: _____

Maintenance Agreement Required: ☐ Yes ☑ No

Gravel Depth 24"

☐ House/Mod. Home No. Bedrooms 3

☑ Mobile Home No. Bathrooms 2

☐ Business No. Employees _____

☐ Other _____


☐ Slab ☑ Crawl Space ☐ Basement w/plumbing ☐ Basement wo/plumbing

Water Supply: ☑ Individual ☐ Public ☐ Community

Comments:/Conditions: REMOVE EXISTING DISTRIBUTION BOX & ~~SOME~~ INSTALL NEW SCH 40 PIPE FEEDING UPPER LINE, INSTALL NEW DROP BOXES AS SHOWN FOR SERIAL DISTRIBUTION & NEW 3' x 80' LINE AS SHOWN ON CONTOUR USING 24" STONE.

Comments:/Conditions: THIS PERMIT SERVES AS "NOTICE OF VIOLATION" SYSTEM TO BE REPAIRED BY OCTOBER 18, 2003 OR PRIOR TO OCCUPATION, WHICH EVER COMES FIRST

INITIAL SITE SKETCH

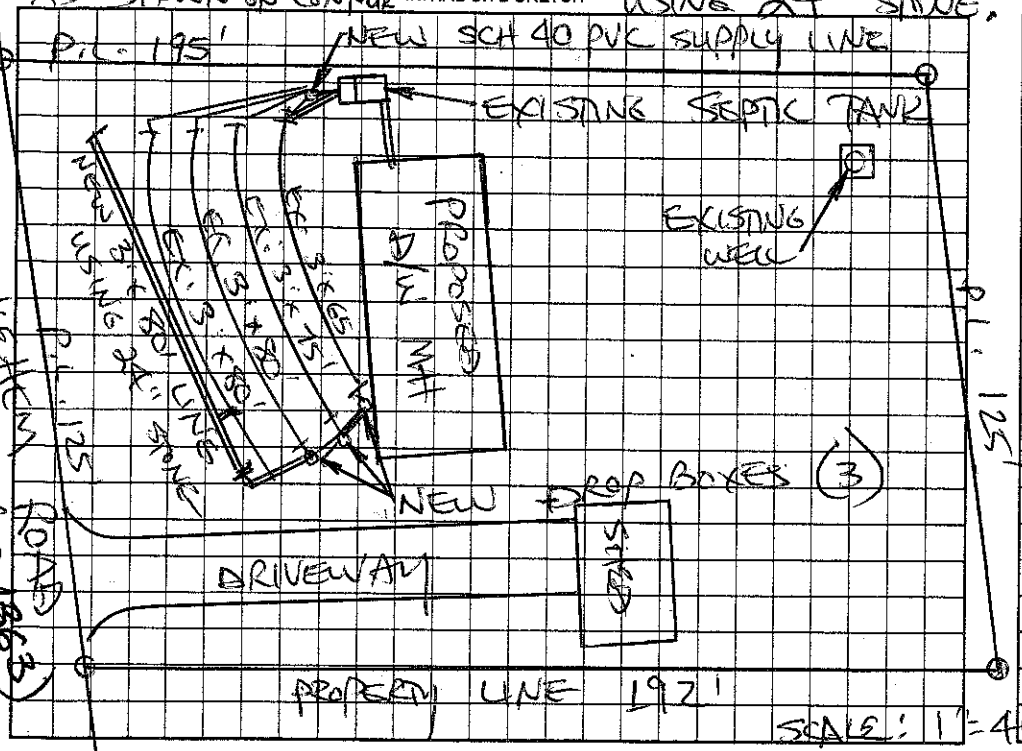

AS BUILT SKETCH

SYSTEM REPAIRED ACCORDING TO INITIAL SITE SKETCH

Permit can be suspended or revoked if any false information is supplied toward securing the permit/any unauthorized changes are made to the site/any unauthorized changes are made in the installation of the system. Improvement Permit with plat valid without expiration. Improvement Permit with site plan valid for sixty months. Authorization to Construct is valid for a period equal to that of Improvement Permit – not to exceed sixty months.

Signed: Ray Stewart date 9-18-03 Installed by: TOMMY COTHREN

Improvement Permit by: STEVE HENDRICK date 9-18-03 Operation Permit by: STEVE HENDRICK date 12-12-03

Authorization to Construct by: STEVE HENDRICK date 9-18-03 Existing System Inspection by: _____ date _____

HEALTH DEPT. COPY: WHITE OWNER COPY (FINAL): YELLOW OWNER COPY (INITIAL): PINK