022032

IREDELL COUNTY HEALTH DEPARTMENT

STATESVILLE 704-878-5305 MOORESVILLE 704-664-5281

IMPROVEMENT PERMIT / CERTIFICATE OF COMPLETION / OPERATION PERMIT / EXISTING SYSTEM INSPECTION

PROPERTY DESCRIPTION NO. 22032 DATE 9-12-95 TAX MAP NO. 8K-F-15 (pt) Watershed: ☐ Yes ☐ No

OWNER OR CONTRACTOR Bob Compton PHONE: Business _____ Home 872-2957

ADDRESS 123 Rockwood Lane

LOCATION 70 W Tl Old Mtn Rd Tl Bethleham Rd Tl Happy Un Towards end rt.

SUBDIVISION Carson Park BLOCK / SECTION _____ LOT 10 LOT AREA 181x200 SITE CLASS. PS DESIGN FLOW 360 L.T.A.R. 135

Septic Tank: 1000 Gallons; STB 1012 Date 1-26-96 ☐ New System ☐ Repair System Type: I, II, III, IV, V, VI

Pump Tank: _____ Gallons; PT _____ Date _____ System Description: Conv. Gravity

Pump Make: _____ Model _____ Serial No. _____ Repair System Description: _____

Nitrification Field: No. Fields 1 Square Feet 1050 Linear Feet 350 Maintenance Agreement Required: ☐ Yes ☒ No

~~No Lines~~ 4 Trench Width 36" Max Trench Bottom Depth 36" Gravel Depth 12"

☐ House/Mod. Home No. Bedrooms 3

☒ Mobile Home No. Bathrooms 2

☐ Business No. Employees _____


☐ Other _____

☐ Slab ☐ Crawl Space ☐ Basement w/plumbing ☐ Basement wo/plumbing

Water Supply:
☒ Individual
☐ Community
☐ Public

Comments:

INITIAL SITE SKETCH

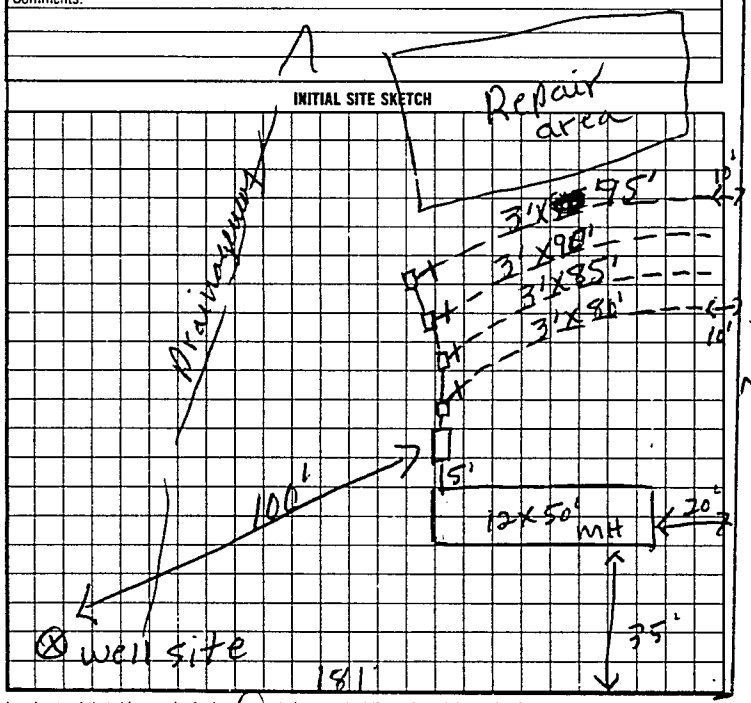

Comments:

Well not located at Time of This inspection Keep Proper Distance from S.T. System

AS BUILT SKETCH

Same as initial Sketch

I understand that this permit can be suspended or revoked if any false information is supplied toward securing the permit/any unauthorized changes are made to the site/any unauthorized changes are made in the installation of the system.

Signed: x Bob Compton

Improvement Permit by: P.C. Moore date 9-12-95

Existing System Inspection by: _____ date _____

Installed by: B. Sigmon Const. Co.

Certificate of Completion by: _____ date _____

Operation Permit by: P.C. Moore date 4-4-96

HEALTH DEPT. COPY: WHITE INSPECTION COPY (FINAL): GREEN OWNER COPY (FINAL): YELLOW INSPECTION COPY (INITIAL): PINK OWNER COPY (INITIAL): GOLD

2862200