IREDELL COUNTY HEALTH DEPARTMENT

Statesville Office (704) 878-5305 Mooresville Office (704) 660-3625 PERMIT # 224532

IMPROVEMENT PERMIT / AUTHORIZATION TO CONSTRUCT / OPERATION PERMIT / EXISTING SYSTEM

PIN # 4713-67-6396

APPLICANT: Richard Hertler APPLICANT ADDRESS: 134 Happy Lane Statesville, NC 28677

SITE ADDRESS: 134 Happy Lane Statesville, NC 28677 PHONE: 704-657-8605 ALT. PHONE:

SITE DIRECTIONS: Old Mountain Rd N from Troutman → R on Bethlehem Rd → L on Happy Lane

SUBDIVISION: Garden Park Estate SECTION: LOT # 2 LOT AREA: 0.5 acres DESIGN FLOW: 240 GPD L.T.A.R.:


Septic Tank	Ex 1000 (gal)	STB 1012	Date 1-20-1996	☐ New System ☐ Repair ☐ Expansion	System Type: I (II) III IV V VI	☒ Residence	No. Bedrooms 2
Pump Tank	— (gal)	PT —	Date —	System Description:	Existing - Conv. Gravel	☐ Business	No. Persons 4
Pump Make	—	Model —	Serial # —	Repair System Description:	Existing - Conv. Infiltrator	☐ Other	No. Employees
# Nitrification Fields	Ex 1	# Lines Ex 5	Linear Ft: 400	Maintenance Agreement Required:	☐ YES ☒ NO	☐ Slab	☒ Crawl Space
Trench Width	36" Ex	Max. Trench Bottom Depth Ex 36"		Gravel Depth Ex 36"	☒ GRAVITY ☐ PRESSURE	☐ Basement w/plumbing	☐ Basement w/o plumbing

Water Supply: ☒ Private ☐ Public ☐ Community

Comments / Conditions: Existing system permit. Though the applicant wishes to construct a 2-Bedroom Home, the original IGHD permit (dated 9-12-95) allows for up to a 3 Bedroom house. Likewise, a 1-Bedroom addition/expansion to the 2-Bedroom house may be allowed.

★ Strongly recommend pumping the septic tank every 3-5 years. ★

INITIAL SITE SKETCH

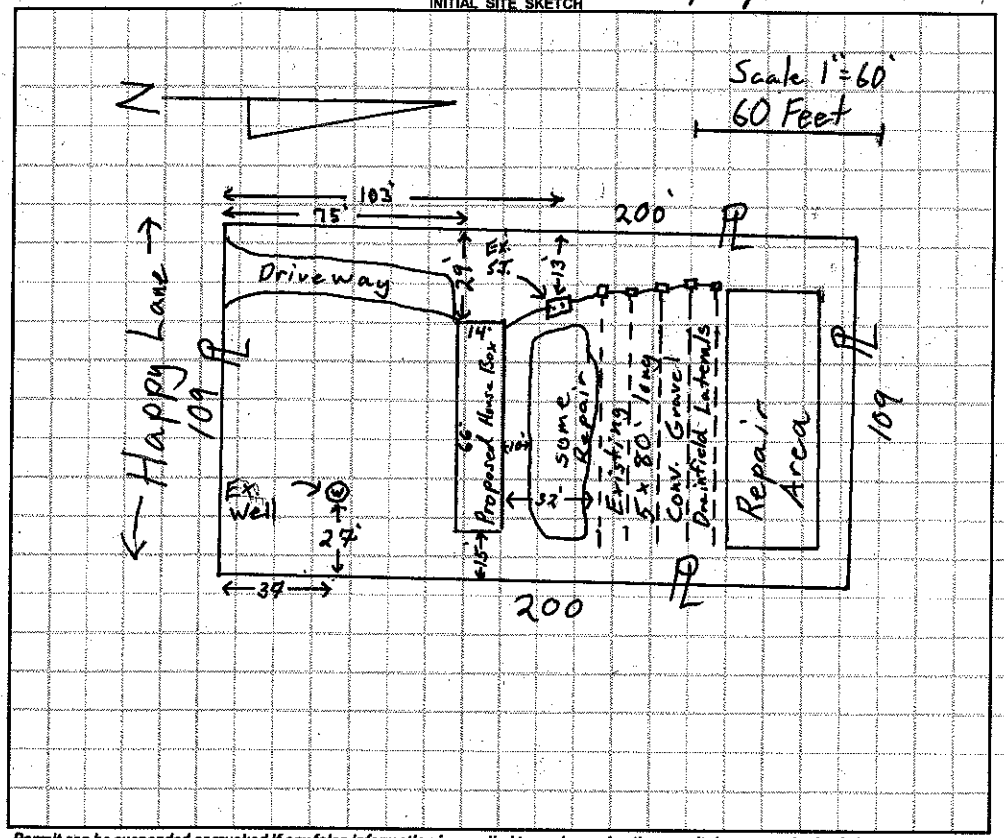

AS BUILT SKETCH

Permit can be suspended or revoked if any false information is supplied toward securing the permit / any unauthorized changes are made to the site / any unauthorized changes are made in the installation of the system. **CONTACT A LOCATOR SERVICE PRIOR TO ANY EXCAVATION**


☐ **IMPROVEMENT PERMIT** *with plat valid without expiration.* ☐ **IMPROVEMENT PERMIT** *with site plan valid for 60 mos.* ☐ **AUTHORIZATION TO CONSTRUCT** *valid for period equal to IMPROVEMENT PERMIT--not to exceed 60 mo.*

Owner / Applicant Signature: Richard Hertler Date: Installed by:

IMPROVEMENT PERMIT by: Date: OPERATION PERMIT by: Date:

AUTHORIZATION TO CONSTRUCT by: Date: Existing System Inspected by: Tom Shuck Date: 2-15-17

Health Dept. Copy - WHITE Applicant (Final Approval) - YELLOW Applicant (Conditional Approval) - PINK

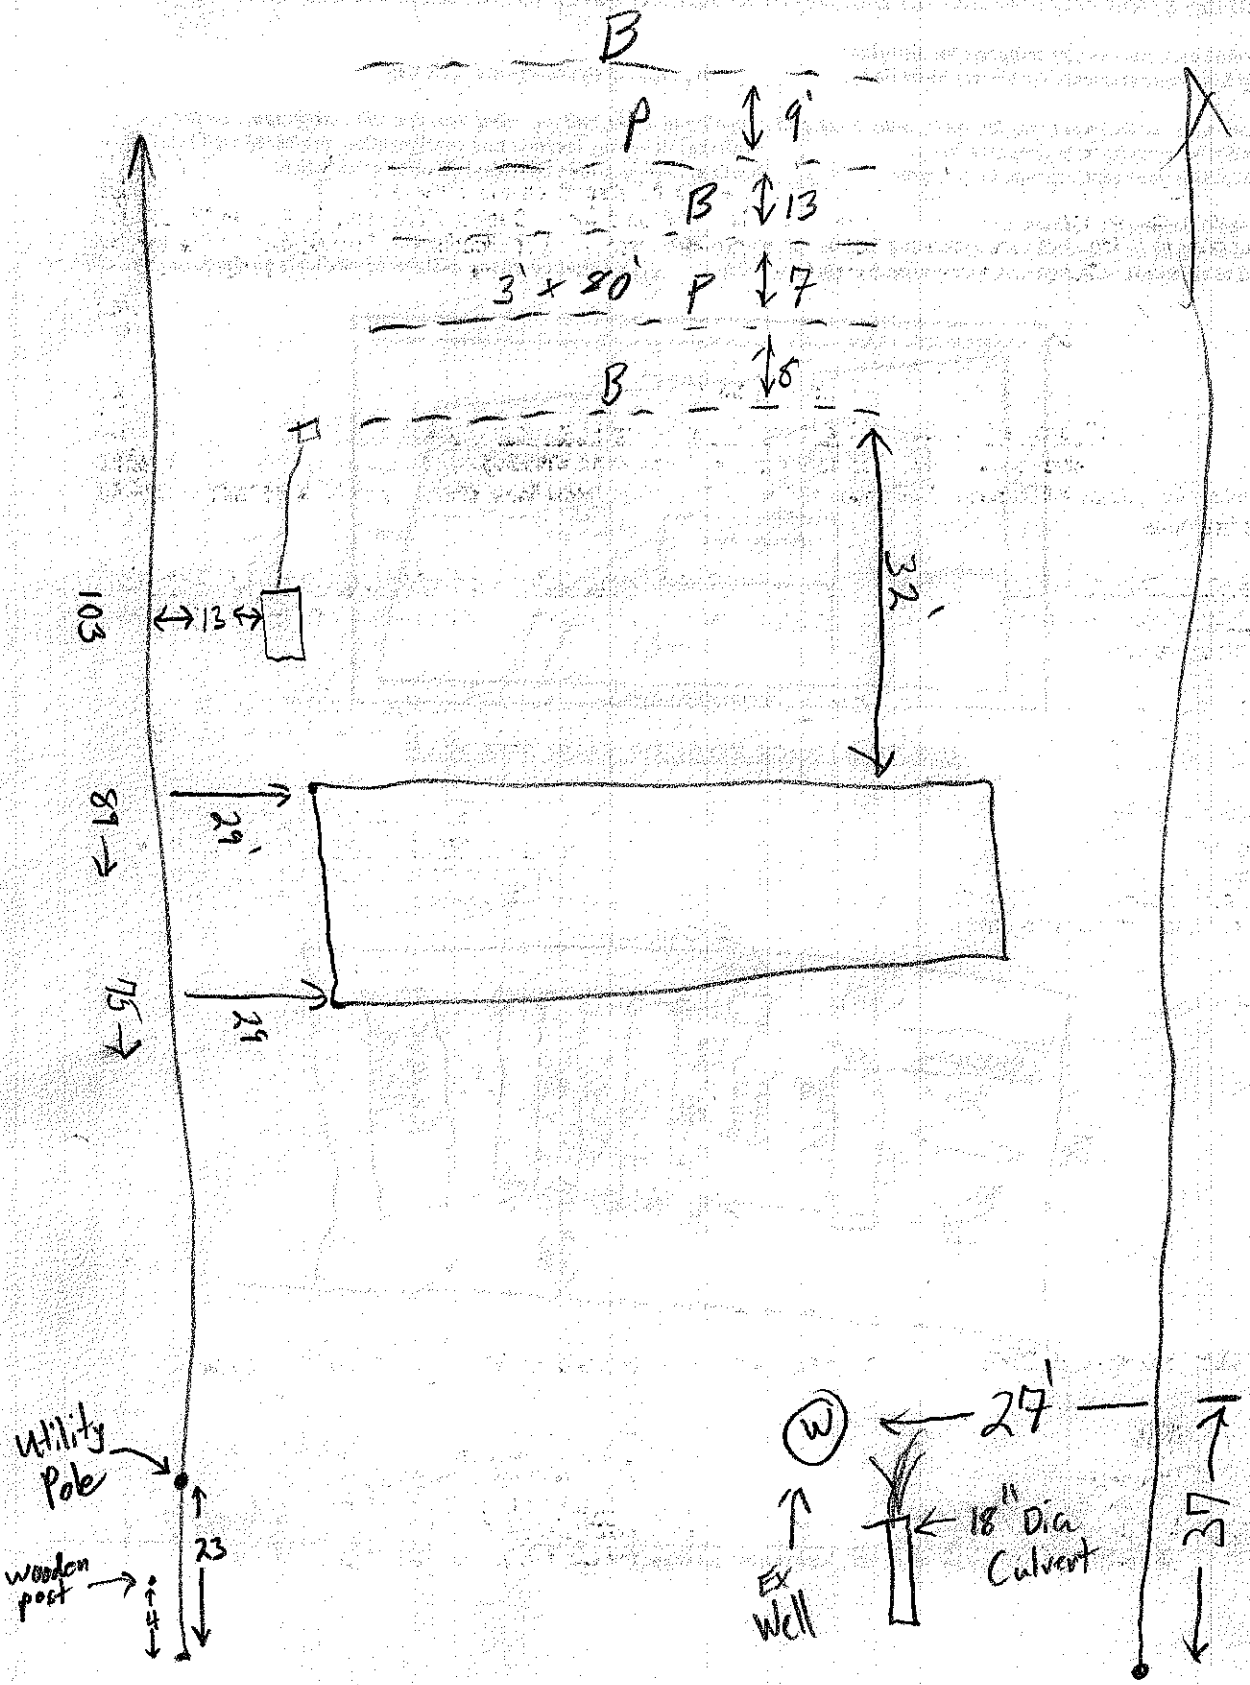
B
P
9'
B
13
3' x 80'
P
7
B
8
32'
103
13
89
29'
29'
75
Utility Pole
23
wooden post
4'
W
27'
18" Dia Culvert
Ex Well
75'