IREDELL COUNTY HEALTH DEPARTMENT

STATESVILLE 704-878-5305 MOORESVILLE 704-664-5281

IMPROVEMENT PERMIT / CERTIFICATE OF COMPLETION / OPERATION PERMIT / EXISTING SYSTEM INSPECTION

PROPERTY DESCRIPTION NO. 18923 DATE 8-30-94 TAX MAP NO. Pt. of 8K-F-15 Watershed: ☐ Yes ☑ No

OWNER OR CONTRACTOR J. R. Padgette PHONE: Business _____ Home 881-0305

ADDRESS Rt 6 Box 317-B Statesville, N.C. 28677

LOCATION I40W TL Old Mtn. Rd. TL Bethlehem Rd. TL Warren Rd. (past Mtn. Rd Village) 1st Lot on R.

SUBDIVISION Eagley Warren Prop. BLOCK / SECTION _____ LOT 1 LOT AREA 217' X 200' SITE CLASS. P.S DESIGN FLOW 360 L.T.A.R. .35 gpd/ft²

Septic Tank: 1000 Gallons; STB 794 Date 7-4-94
Pump Tank: — Gallons; PT — Date —
Pump Make: — Model — Serial No. —
Nitrification Field: No Fields 1 Square Feet 1035 Linear Feet 345'
No Lines 3 Trench Width 36" Max Trench Bottom Depth 24"-30" Gravel Depth 12"

☑ New System ☐ Repair System Type: I, II, III, IV, V, VI
System Description: conventional; gravity fed
Repair System Description: " "
Maintenance Agreement Required: ☐ Yes ☑ No


☐ House/Mod. Home No. Bedrooms 3
☑ Mobile Home No. Bathrooms 2
☐ Business No. Employees ____
☐ Other ____
☐ Slab ☑ Crawl Space ☐ Basement w/plumbing ☐ Basement wo/plumbing

Water Supply: ☐ Individual ☐ Community ☑ Public


Comments: INSTALL SYSTEM SHALLOW (no deeper than 30" to trench bottom) Keep lines and trenches on contour. Keep system 5' from foundation of home, 10' from all property lines, and 10' from water line 100% Repair above and below system, conventional gravity fed.

Comments: Home not located at time of inspection. Keep home min. 5' from any part of system. Keep water line 10' from any part of septic system.

INITIAL SITE SKETCH

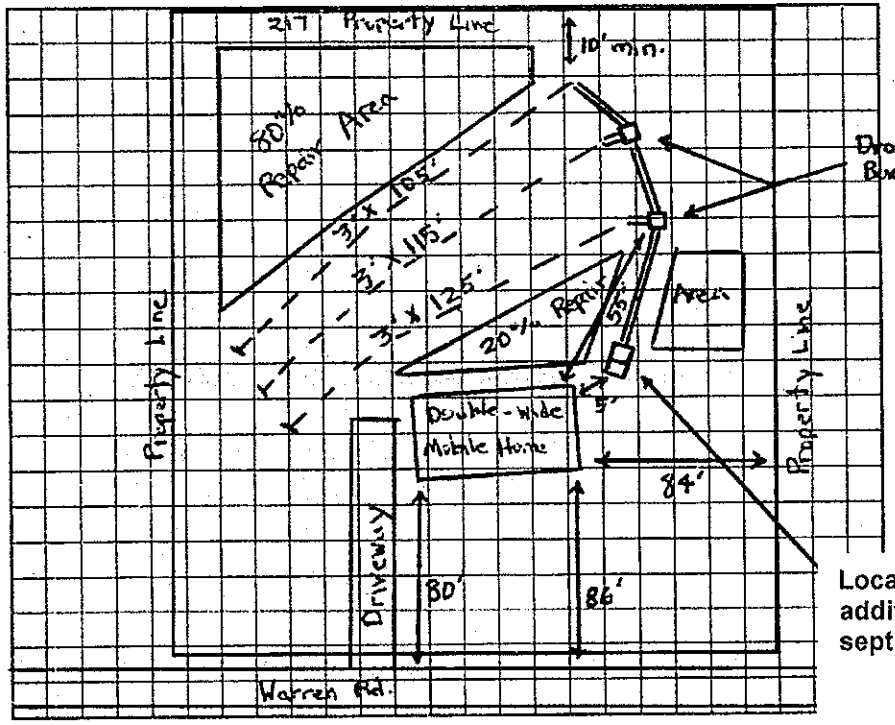

AS BUILT SKETCH

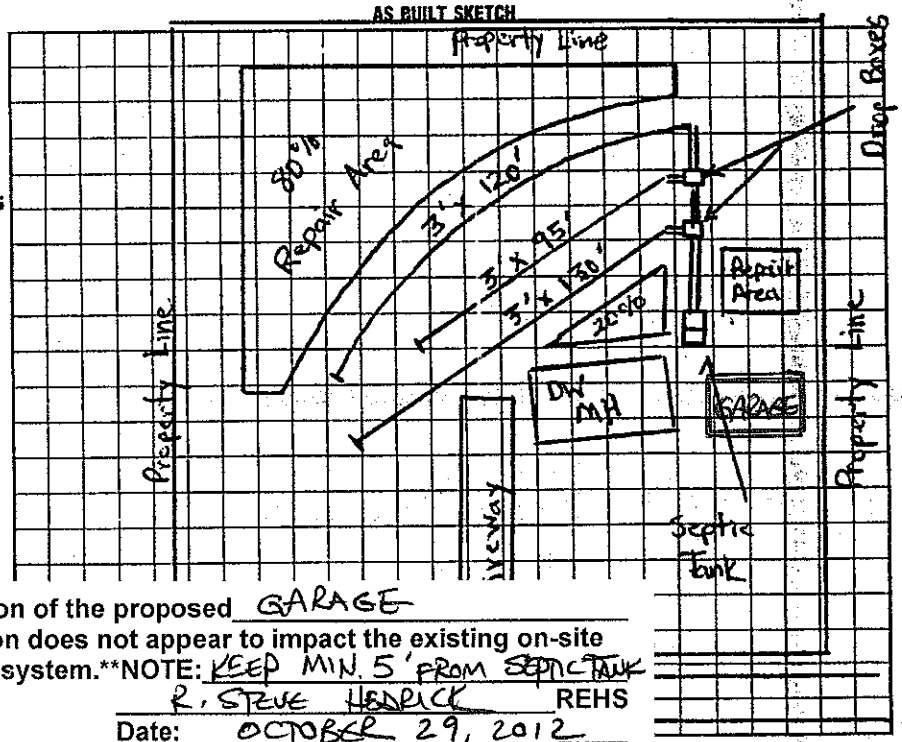

Location of the proposed GARAGE addition does not appear to impact the existing on-site septic system.**NOTE: KEEP MIN. 5' FROM SEPTIC TANK

R. STEVE HENDRICK REHS

Date: OCTOBER 29, 2012

ICHD-Environmental Health Division

I understand that this permit can be suspended or revoked if any false information is supplied toward secu... n the installation of the system. Improvement Permit is valid for 60 months from date of issuance.

Signed: John R. Padgette

Improvement Permit by: Michael J. Dennis date 8-30-94

Existing System Inspection by: _____ date _____

Installed by: A-1 Backhoe

Certificate of Completion by: Michael J. Dennis date 8-31-94

Operation Permit by: _____ date _____

HEALTH DEPT. COPY: WHITE INSPECTION COPY (FINAL): GREEN OWNER COPY (FINAL): YELLOW INSPECTION COPY (INITIAL): PINK OWNER COPY (INITIAL): GOLD