IREDELL COUNTY HEALTH DEPARTMENT

THIS PERMIT VOIDS PREVIOUS ISSUED 1-2-97

STATESVILLE 704-878-5305 MOORESVILLE 704-664-5281

IMPROVEMENT PERMIT / AUTHORIZATION TO CONSTRUCT / OPERATION PERMIT / EXISTING SYSTEM INSPECTION

PERMIT# 79442 25737 PIN# 4713 70 9827 DATE 3-19-99

OWNER OR CONTRACTOR STEVEN & AMY COLEMAN PHONE: Business Home

ADDRESS ASHLEYBROOK DRIVE STATESVILLE, NC 28677

LOCATION I-40W, TL OLD MOUNTAIN ROAD, TR PLEASANT DRIVE, 12TH LOT ON LEFT ~ 400' OFF ROAD

SUBDIVISION WARREN EST BLOCK / SECTION LOT 13 LOT AREA 5.95 ACRES SITE CLASS PS DESIGN FLOW 360 L.T.A.R. 0.30 GPD/FT²

Septic Tank: 1000 Gallons: STB 794 Date 12-11-98

Pump Tank: Gallons: PT Date

Pump Make: Model Serial No

Nitrification Field: No Fields 1 Square Feet 1200 Linear Feet 400

No Lines FOUR Trench Width 36" Max Trench Bottom Depth 30" Gravel Depth

✓ New System Repair System Type: I II III IV V VI

System Description: CONVENTIONAL GRAVITY

Repair System Description: CONV. GRAVITY

Maintenance Agreement Required Yes ✓ No

✓ House/Mod. Home No. Bedrooms 3

[redacted] No. Bathrooms 2

Business No. Employees

Other


Slab ✓ Crawl Space Basement w/plumbing Basement wo/plumbing

Water Supply: ✓ Individual ☐ Public ☐ Community WELL


Comments/Conditions ① KEEP SYSTEM MINIMUM 100 FEET FROM WELL ② INSTALL SUBSURFACE INTERCEPT DRAINAGE DITCH 42" DEEP, TO DAYLIGHT

Comments/Conditions

INITIAL SITE SKETCH

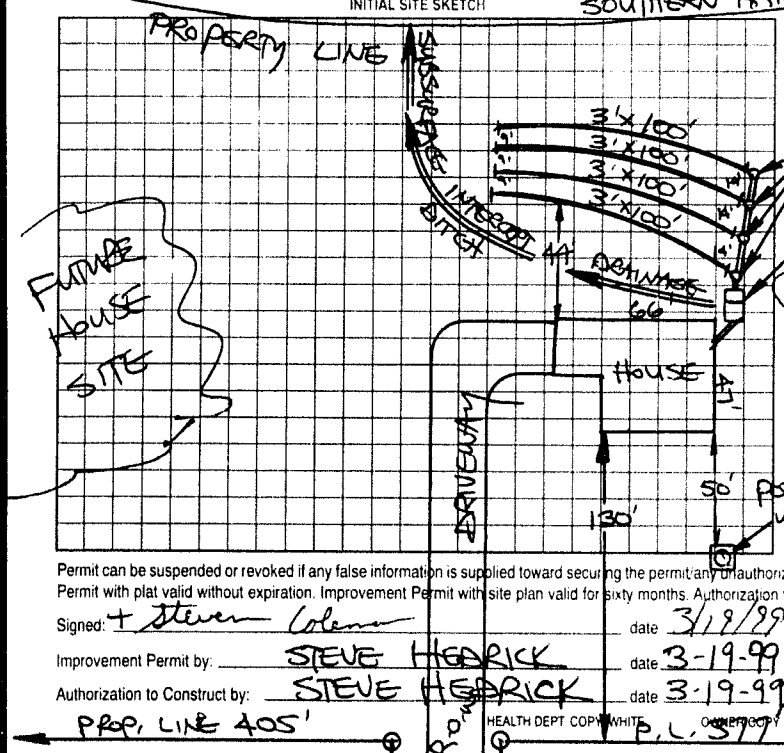

AS BUILT SKETCH

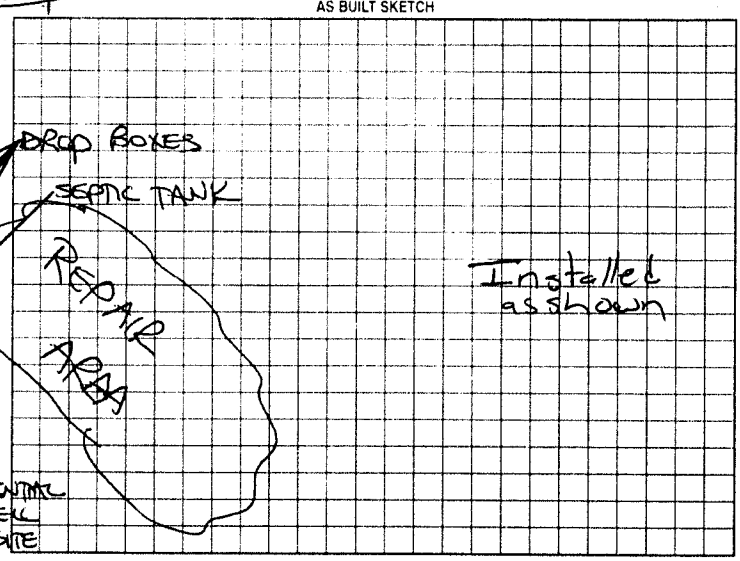

Permit can be suspended or revoked if any false information is supplied toward securing the permit/any unauthorized changes are made to the site/any unauthorized changes are made in the installation of the system. Improvement Permit with plat valid without expiration. Improvement Permit with site plan valid for sixty months. Authorization to Construct is valid for a period equal to that of Improvement Permit - not to exceed sixty months.

Signed: + Steven Coleman date 3/19/99 Installed by: James Hudler

Improvement Permit by: STEVE HEDRICK date 3-19-99 Operation Permit by: [illegible] RS date 4-19-99

Authorization to Construct by: STEVE HEDRICK date 3-19-99 Existing System Inspection by: date

HEALTH DEPT COPY WHITE OWNER COPY (FINAL) YELLOW OWNER COPY (INITIAL) PINK