46683

IREDELL COUNTY HEALTH DEPARTMENT

STATESVILLE 704-878-5305 MOORESVILLE 704-664-5281

IMPROVEMENT PERMIT / CERTIFICATE OF COMPLETION / OPERATION PERMIT / EXISTING SYSTEM INSPECTION

PROPERTY DESCRIPTION NO. 16006 DATE 10-7-93 TAX MAP NO. 8K-10-A-11

OWNER OR CONTRACTOR Kevin Scott Sherrill PHONE: Business _____ Home 873-1391

ADDRESS Rt. 17 Box 174 Statesville, N.C. 28677

LOCATION I40W TL Old Mtn. Rd. TR Pleasent Dr. (Warren Estates) 11th Lot on L

SUBDIVISION Warren Estates BLOCK / SECTION _____ LOT 11 LOT AREA 2134' x 252' SITE CLASS. P.S. L.T.A.R. .35 gpd/ft²

Water Supply: ☑ Individual ☐ Community ☐ Public Well

Septic Tank: 1000 Gallons; STB 358 Date 8-15-93

Pump Tank: — Gallons; PT — Date —

Nitrification Field: No Fields 1 Square Feet 1035 Linear Feet 345'

No Lines 4 Trench Width 36" Trench Depth 18"-36" Gravel Depth 12"

☑ New System ☐ Repair System Type: I. (II.) III. IV. V. VI

System Description: Conventional, gravity fed

Repair System Description: " "

Maintenance Agreement Required: ☐ Yes ☑ No

☑ House/Mod. Home No. Bedrooms 3 Garbage Disposal: ☐ Yes ☑ No

☐ Mobile Home No. Bathrooms 2.5 Auto. Dishwasher: ☑ Yes ☐ No

☐ Business No. Employees — Auto. Washing Machine: ☑ Yes ☐ No


☐ Other _____ Other _____

☐ Slab ☑ Crawl Space ☐ Basement w/plumbing ☐ Basement wo/plumbing

Comments 100% Repair Area below System, conventional, gravity fed.

INITIAL SITE SKETCH

AS BUILT SKETCH

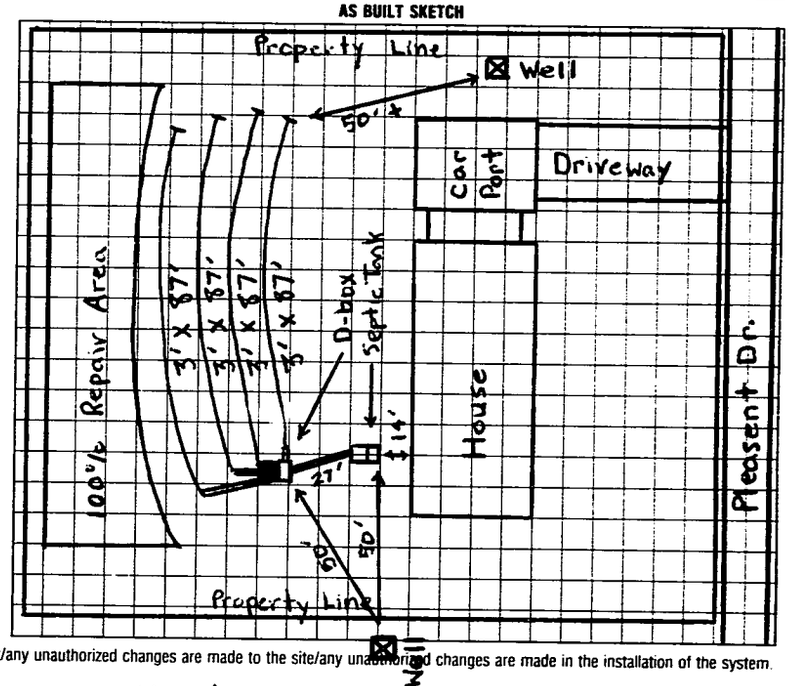

I understand that this permit can be suspended or revoked if any false information is supplied toward securing the permit/any unauthorized changes are made to the site/any unauthorized changes are made in the installation of the system. Improvement Permit is valid for 60 months from date of issuance.

Signed: _____

Improvement Permit by: Michael G. Dennis date 3-23-93

Existing System Inspection by: _____ date _____

Installed by: Eddie Yountz and sons.

Certificate of Completion by: Michael G. Dennis date 10-7-93

Operation Permit by: _____ date _____

HEALTH DEPT. COPY: WHITE INSPECTION COPY (FINAL): GREEN OWNER COPY (FINAL): YELLOW INSPECTION COPY (INITIAL): PINK OWNER COPY (INITIAL): GOLD