IREDELL COUNTY HEALTH DEPARTMENT

STATESVILLE 704-878-5305 Repair MOORESVILLE 704-664-5281

IMPROVEMENT PERMIT / AUTHORIZATION TO CONSTRUCT / OPERATION PERMIT / EXISTING SYSTEM INSPECTION

PERMIT# _____ PIN# _____

OWNER OR CONTRACTOR Donald DeWald PHONE: Business _____ Home 871 9866 DATE Apr. 1 19 2000

ADDRESS 471 Bethelam Rd

LOCATION Hwy 70 West ② Bethelam Rd ~~AAX~~ 1/4 mile past The Landings on Left Access From Happy Lane

SUBDIVISION _____ BLOCK / SECTION _____ LOT _____ LOT AREA _____ SITE CLASS. _____ DESIGN FLOW _____ L.T.A.R. _____

Septic Tank: 1000 Gallons; STB 794 Date 5-10-99
Pump Tank: _____ Gallons; PT _____ Date _____
Pump Make: _____ Model _____ Serial No. _____
Nitrification Field: No Fields ~~Square Feet~~ _____ Linear Feet _____
No Lines _____ Trench Width _____ Max Trench Bottom Depth _____ Gravel Depth _____

☐ New System ☑ Repair System Type: I. II. III. IV. V. VI
System Description: _____
Repair System Description: _____
Maintenance Agreement Required: ☐ Yes ☑ No

☐ House/Mod. Home ☑ Mobile Home ☐ Business ☐ Other
No. Bedrooms 3 No. Bathrooms 2 No. Employees _____


☐ Slab ☑ Crawl Space ☐ Basement w/plumbing ☐ Basement wo/plumbing

Water Supply: ☑ Individual ☐ Public ☐ Community well


Comments:/Conditions: Replace Septic Tank Pump out And Remove ~~Crush~~ old Tank, May place new Tank up hill To Stay Away From old Tank. Locate Distribution Box on 1st Line And insure GRAVITY Fall From New Tank

Comments:/Conditions:

INITIAL SITE SKETCH

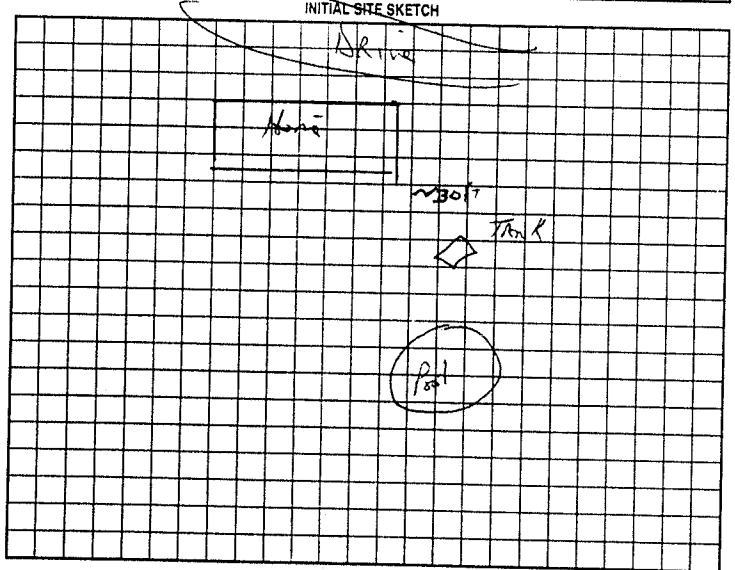

AS BUILT SKETCH

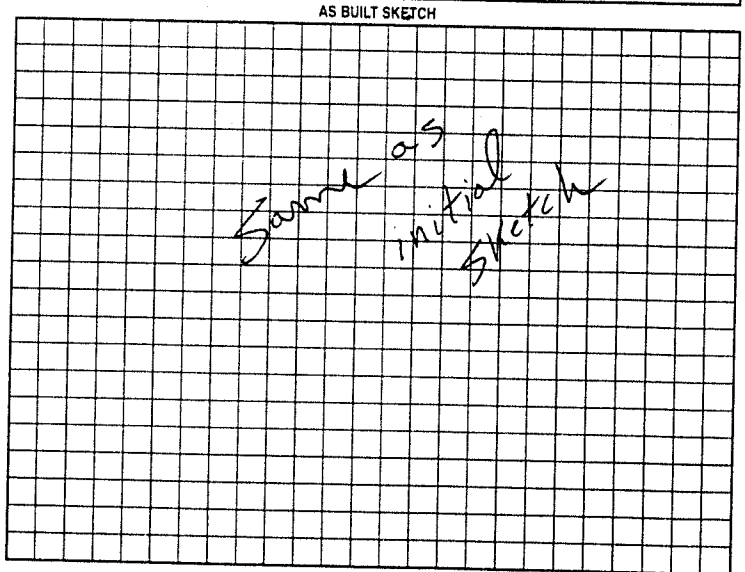

Permit can be suspended or revoked if any false information is supplied toward securing the permit/any unauthorized changes are made to the site/any unauthorized changes are made in the installation of the system. Improvement Permit with plat valid without expiration. Improvement Permit with site plan valid for sixty months. Authorization to Construct is valid for a period equal to that of Improvement Permit – not to exceed sixty months.

Signed: Lou DeWald date 4-19-00 Installed by: Dale Vaughn

Improvement Permit by: Joe Potter date April 19 2000 Operation Permit by: J. C. Moore date 4-20-00

Authorization to Construct by: Joe Potter date April 19 2000 Existing System Inspection by: _____ date _____

HEALTH DEPT. COPY: WHITE OWNER COPY (FINAL): YELLOW OWNER COPY (INITIAL): PINK