IREDELL COUNTY HEALTH DEPARTMENT

STATESVILLE 704-878-5305 MOORESVILLE 704-664-5281

63202

IMPROVEMENT PERMIT / CERTIFICATE OF COMPLETION / OPERATION PERMIT / EXISTING SYSTEM INSPECTION

PROPERTY DESCRIPTION NO. 24729 DATE 9-5-96 TAX MAP NO. 8K-10-A-26+29 Watershed: ☐ Yes ☑ No

OWNER OR CONTRACTOR R. E. Fraver PHONE: Business Home 873-6101

ADDRESS 130 Hamilton Dr. Troutman

LOCATION Old Mtn Rd Turn Pleasant Dr onRt

SUBDIVISION Warren Est. BLOCK / SECTION LOT 26+27 LOT AREA 1.5 acres SITE CLASS. PS DESIGN FLOW 360 L.T.A.R. 125

Septic Tank: 1000 Gallons; STB 1012 Date 8-20-96

Pump Tank: Gallons; PT 1080 Date

Pump Make: Model Serial No. 360

Nitrification Field: No Fields 1 Square Feet ~~1440~~ Linear Feet ~~450~~

No Lines 4 Trench Width 36" Max Trench Bottom Depth 24" Gravel Depth 12"

☑ New System ☐ Repair System Type: I, II, III, IV, V, VI

System Description: ~~Gravity Chambers~~ Cultec

Repair System Description: LPP

Maintenance Agreement Required: ☐ Yes ☑ No

☑ House/Mod. Home No. Bedrooms 3

☐ Mobile Home No. Bathrooms 2

☐ Business No. Employees


☐ Other

☐ Slab ☑ Crawl Space ☐ Basement w/plumbing ☐ Basement wo/plumbing


Water Supply: ☑ Individual ☐ Community ☐ Public

Comments: 262' Two lots make one b/ild. site (360' of Chambers used)

INITIAL SITE SKETCH

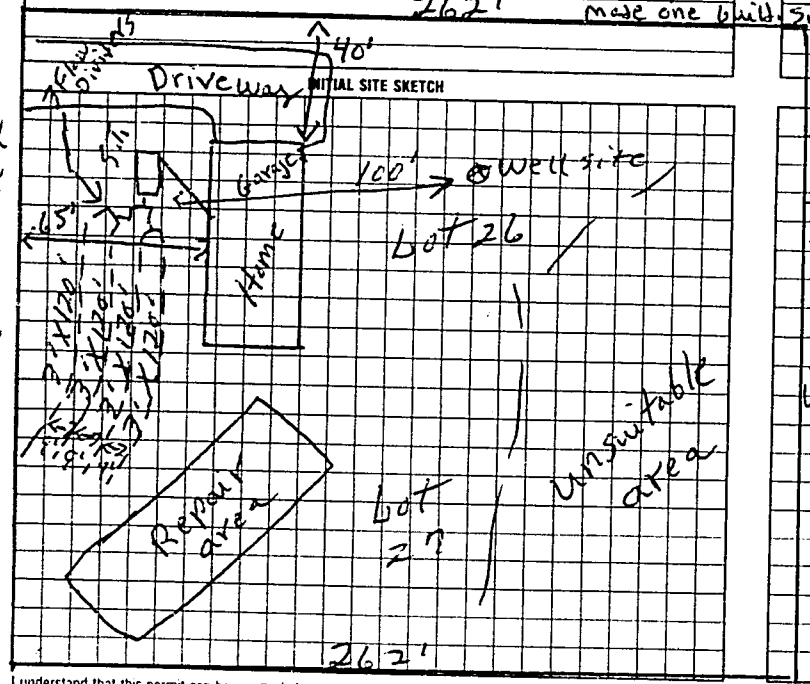

AS BUILT SKETCH

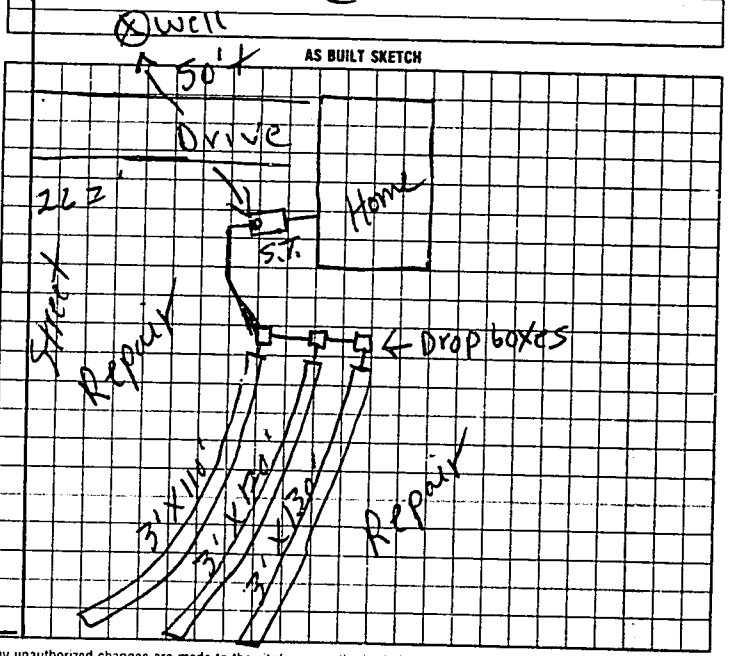

I understand that this permit can be suspended or revoked if any false information is supplied toward securing the permit/any unauthorized changes are made to the site/any unauthorized changes are made in the installation of the system.

Signed: x R E Fraver

Improvement Permit by: J. C. Moore date 9-5-96

Existing System Inspection by: Authorization to count J. C. Moore date 9-5-96

Installed by: Tommy Frye

Certificate of Completion by: date

Operation Permit by J. C. Moore date 1-7-97

HEALTH DEPT COPY WHITE INSPECTION COPY (FINAL) GREEN OWNER COPY (FINAL) YELLOW INSPECTION COPY (INITIAL) PINK OWNER COPY (INITIAL) GOLD

Authorization to count expires 60 mos from 9-5-96