48292

IREDELL COUNTY HEALTH DEPARTMENT

STATESVILLE 704-878-5305 MOORESVILLE 704-664-5281

IMPROVEMENT PERMIT / CERTIFICATE OF COMPLETION / OPERATION PERMIT / EXISTING SYSTEM INSPECTION

PROPERTY DESCRIPTION NO. 16758 DATE 8-6-93 TAX MAP NO. 8U-10-A-6

PHONE: Business ______ Home 528-6080

OWNER OR CONTRACTOR Phillip Bumgarner

ADDRESS Troutman N.C.

LOCATION Buffalo Shoals Rd TR old mtn Past Deep Cut TL warren Est. 1/8mi on left

SUBDIVISION warren Est BLOCK / SECTION ______ LOT 6 LOT AREA 130'x250' SITE CLASS. P.S. L.T.A.R. .3

Water Supply: ☑ Individual ☐ Community ☐ Public

Septic Tank: 1000 Gallons; STB 358 Date 10-1-93

Pump Tank: — Gallons; PT — Date —

Nitrification Field: No Fields 1 Square Feet 1200 Linear Feet 400

No Lines 3 Trench Width 36 Trench Depth 18 to 36 Gravel Depth 12

☑ New System ☐ Repair System Type: I, (II), III, IV, V, VI

System Description: Conv. Gravity

Repair System Description: Pressure doset Panel

Maintenance Agreement Required: ☐ Yes ☐ No System Type IV will require maintenance agreement

☑ House/Mod. Home ☐ Mobile Home ☐ Business ☐ Other ______

No. Bedrooms 3 No. Bathrooms 2 No. Employees ______

Garbage Disposal: ☐ Yes ☑ No

Auto. Dishwasher: ☑ Yes ☐ No


Auto. Washing Machine: ☑ Yes ☐ No

Other ______

☐ Slab ☐ Crawl Space ☐ Basement w/plumbing ☐ Basement wo/plumbing

Comments ______

INITIAL SITE SKETCH

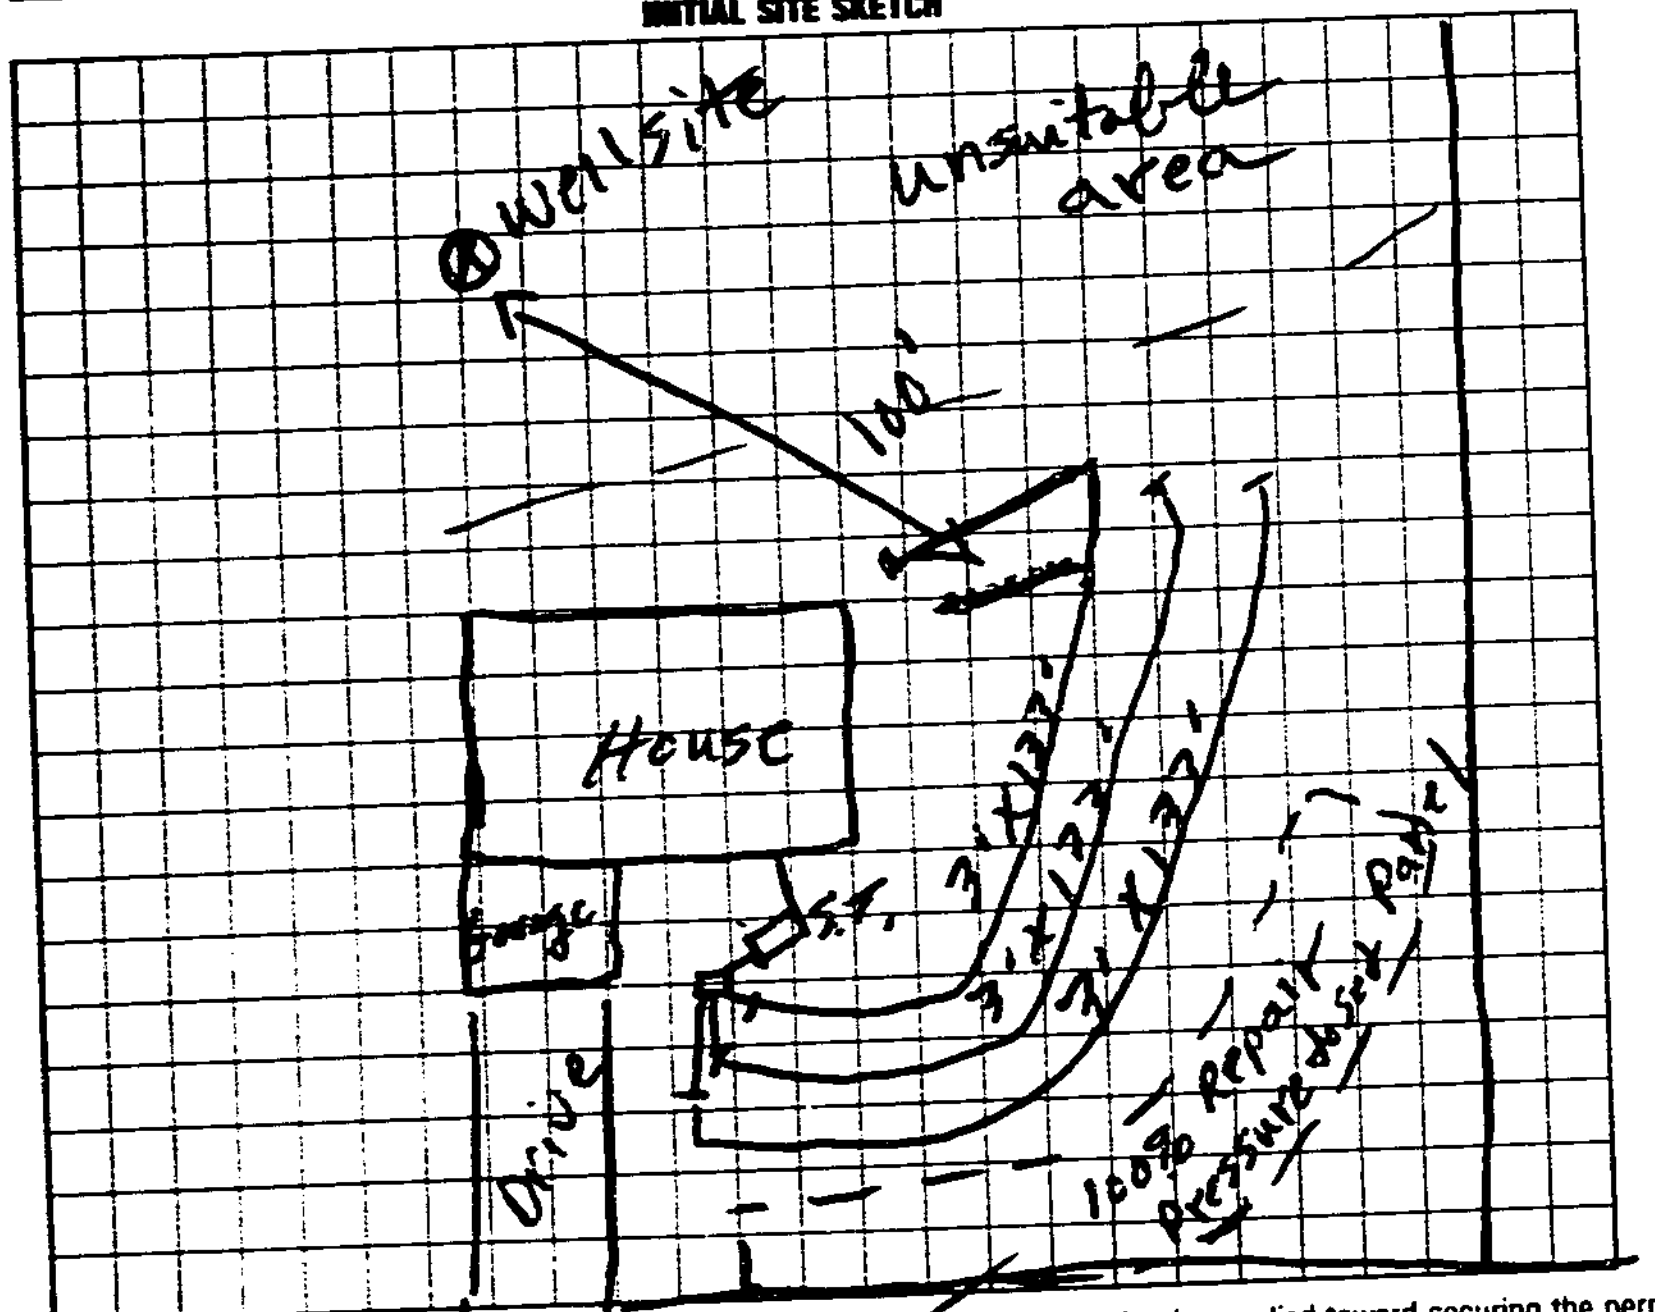

AS BUILT SKETCH

SAME AS INITIAL SKETCH

I understand that this permit can be suspended or revoked if any false information is supplied toward securing the permit/any unauthorized changes are made to the site/any unauthorized changes are made in the installation of the system. Improvement Permit is valid for 60 months from date of issuance.

Signed: x Phillip Bumgarner

Improvement Permit by: L. C. Moore date 8-6-93

Existing System Inspection by: ______ date ______

Installed by: Eddie Yountz and Sons

Certificate of Completion by: Michael J. Dennis date 11-3-93

Operation Permit by: ______ date ______

HEALTH DEPT. COPY: WHITE INSPECTION COPY (FINAL): GREEN OWNER COPY (FINAL): YELLOW INSPECTION COPY (INITIAL): PINK OWNER COPY (INITIAL): GOLD