This permit voids previously issued permit dated 7/16/03.

IREDELL COUNTY HEALTH DEPARTMENT

STATESVILLE 704-878-5305 (C) MOORESVILLE 704-664-5281

IMPROVEMENT PERMIT / AUTHORIZATION TO CONSTRUCT / OPERATION PERMIT / EXISTING SYSTEM INSPECTION

PERMIT# 113712 PIN# 4713-82-~~2356~~ 1206 DATE 3/23/04

OWNER OR CONTRACTOR Cory Turner PHONE: Business 902-3046 Home (704) 528-9842

ADDRESS 116 Admiral Lane Troutman, N.C. 28166

LOCATION I-40W, (E) old mtn Rd, 3rd drive on right past Angel Oaks S/D Entrance, ~ 400 ft off road.

SUBDIVISION — BLOCK / SECTION — LOT — LOT AREA 5.75 Ac. SITE CLASS. PS DESIGN FLOW 360 L.T.A.R. .30 gpd/ft²

Septic Tank: 1,000 Gallons; STB 1007 Date 4-16-04
Pump Tank: ____ Gallons; PT ____ Date ____
Pump Make: ____ Model ____ Serial No. ____
Nitrification Field: No Fields 1 Square Feet 1200 Linear Feet 400
No Lines 4 @ 100' Trench Width 36" Max Trench Bottom Depth 32" Gravel Depth 12"

☒ New System ☐ Repair System Type: (I), II, IV, V, VI
System Description: Gravity Conventional
Repair System Description: Pump, Conventional
Maintenance Agreement Required: ☐ Yes ☒ No


☒ House/Mod. Home No. Bedrooms 3
☐ Mobile Home No. Bathrooms 2½
☐ Business No. Employees ____
☐ Other ____
☐ Slab ☒ Crawl Space ☐ Basement w/plumbing ☐ Basement wo/plumbing

Water Supply: ☒ Individual ☐ Public ☐ Community


Comments:/Conditions: (1) Keep well 100 ft from septic system (2) Install lines on contour.

Comments:/Conditions: - Red Poly-Lok Filter Installed - ST marker Installed

INITIAL SITE SKETCH

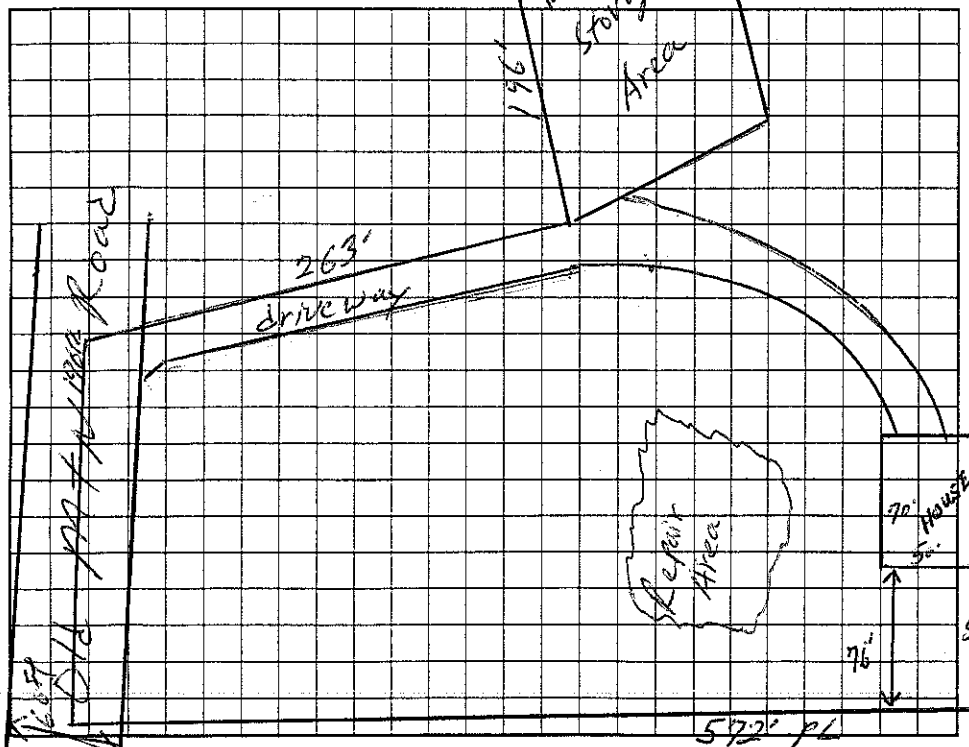

Scale 1" = 100 ft AS BUILT SKETCH

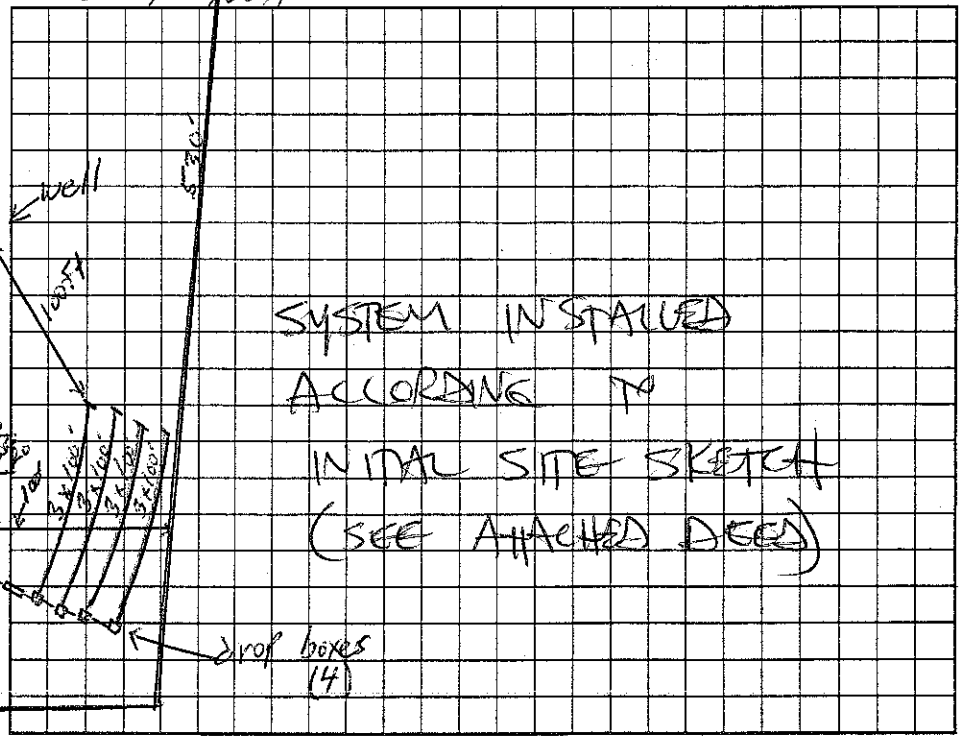

SYSTEM INSTALLED ACCORDING TO INITAL SITE SKETCH (SEE ATTACHED DEED)

Permit can be suspended or revoked if any false information is supplied toward securing the permit/any unauthorized changes are made to the site/any unauthorized changes are made in the installation of the system. Improvement Permit with plat valid without expiration. Improvement Permit with site plan valid for sixty months. Authorization to Construct is valid for a period equal to that of Improvement Permit – not to exceed sixty months.

Signed: Jason Hardebeck date 3/24/04 Installed by: Sammy Shoemaker

Improvement Permit by: William E. Johnson date 3/23/04 Operation Permit by: STEVE HEDRICK date 10-19-04

Authorization to Construct by: William E. Johnson date 3/23/04 Existing System Inspection by: ____ date ____

HEALTH DEPT. COPY: WHITE OWNER COPY (FINAL): YELLOW OWNER COPY (INITIAL): PINK