IREDELL [redacted]TY HEALTH DEPARTMENT

Statesville Phone TR 3-7271 Mooresville Phone NO 3-1271

PERMIT TO INSTALL SEPTIC TANK

Permit NO. JC Camp - Bldr Permit Date Oct 10 1962

Owner L. Warren Address old mtn. Rd

Installed By C Hoke Address R7

Location of Property toward Clarks Hunkle School


1st brick on R Past RR on dup cut.

Tank		Capacity		Length of Lines		Fixtures	
Block	( )	800	( )	150'	( )	No. of Baths	(2)
Precast	(✓)	900	( )	175'	( )	Dishwasher	( )
		1000	(✓)	200'	( )	Garbage Grdr.	( )
		1100	( )	225'	(✓)	Auto-Washer	(✓)
		1200	( )	250'	( )	Other	
		Other		Other			

NOTIFY HEALTH DEPARTMENT AT LEAST EIGHT HOURS BEFORE TANK IS TO BE INSPECTED.

Final Inspection 10-10 1963 Approved (✓) Disapproved ( )

Remarks Well 65'

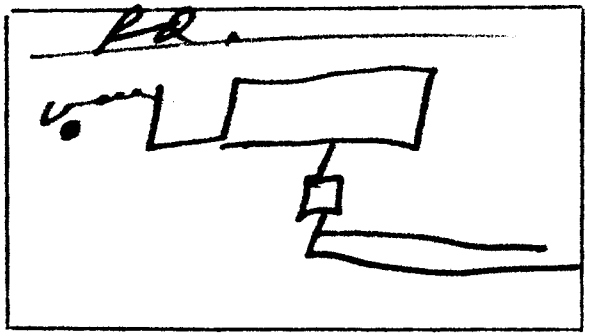

Sketch of Installation

Sanitarian