10 30

IREDELL COUNTY HEALTH DEPARTMENT

STATESVILLE 704-878-5305 MOORESVILLE 704-664-5281

IMPROVEMENT PERMIT / AUTHORIZATION TO CONSTRUCT / OPERATION PERMIT / EXISTING SYSTEM INSPECTION

PERMIT# 076196 PIN# 4713 86 6792 DATE 8/11/00

OWNER OR CONTRACTOR Collier Properties PHONE: Business (704) 924-7120 Home

ADDRESS PO Box 5806 Statesville NC 28677

LOCATION Bethlehem Rd, TL Greenwich near end on RT

SUBDIVISION The Landings BLOCK / SECTION 2 LOT 24/25 LOT AREA 1.03 AC SITE CLASS PS DESIGN FLOW 360 L.T.A.R. 0.5

Septic Tank: 1000 Gallons; STB 1012 Date 9/13/00
Pump Tank: 1000 Gallons; PT 17 Date 9/16/00
Pump Make: Hydromatic Model SHEF40A1 Serial No 189593
Nitrification Field: No Fields 1 Square Feet 900 Linear Feet 300
No Lines 4 @ 75' Trench Width 36" Max Trench Bottom Depth 18" Gravel Depth —

[X] New System [ ] Repair System Type: I, II, III, IV, V, VI
System Description: Press. Man. 25% Red. Shallow
Repair System Description: LPP
Maintenance Agreement Required: [ ] Yes [X] No


[X] House/Mod. Home No. Bedrooms 3
[ ] Mobile Home No. Bathrooms 2
[ ] Business No. Employees
[ ] Other
[ ] Slab [X] Crawl Space [ ] Basement w/plumbing [ ] Basement wo/plumbing

Water Supply: [ ] Individual [X] Public [ ] Community

Comments/Conditions:

Comments/Conditions: Line + tanks check + pressure set GM 10/13/00

INITIAL SITE SKETCH

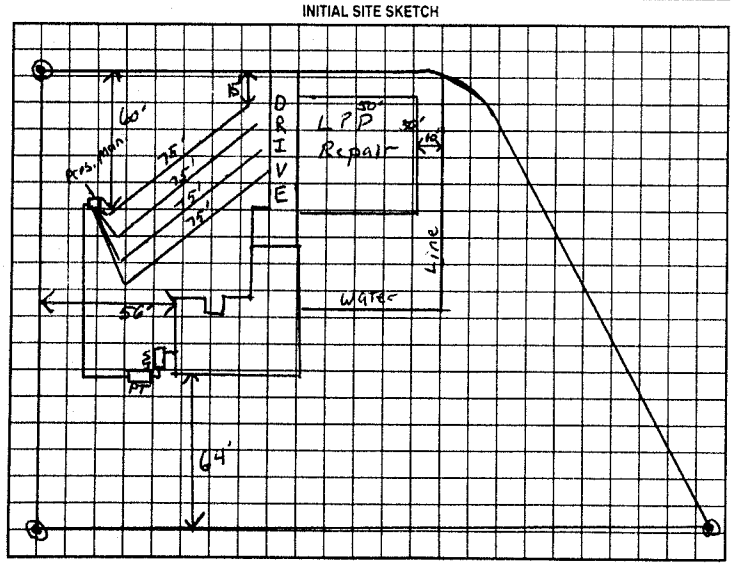

AS BUILT SKETCH

Permit can be suspended or revoked if any false information is supplied toward securing the permit/any unauthorized changes are made to the site/any unauthorized changes are made in the installation of the system. Improvement Permit with plat valid without expiration. Improvement Permit with site plan valid for sixty months. Authorization to Construct is valid for a period equal to that of Improvement Permit – not to exceed sixty months.

Signed: [signature] date 8/16/00 Installed by:

Improvement Permit by: [signature] RSE date 8/11/00 Operation Permit by: [signature] RSJ date 12/22/00

Authorization to Construct by: [signature] RSJ date 8/11/00 Existing System Inspection by: date

HEALTH DEPT. COPY: WHITE OWNER COPY (FINAL): YELLOW OWNER COPY (INITIAL): PINK