IREDELL COUNTY HEALTH DEPARTMENT

STATESVILLE 704-878-5305 MOORESVILLE 704-664-5281

IMPROVEMENT PERMIT / AUTHORIZATION TO CONSTRUCT / OPERATION PERMIT / EXISTING SYSTEM INSPECTION

PERMIT# 75720 PIN# 4713 86 6792 DATE 8-12-98

OWNER OR CONTRACTOR Collier Properties PHONE: Business 924 7120 Home

ADDRESS PO Box 5304 Statesville

LOCATION 70W TO Bethlehem Rd TO Greenwich Road To End on left

SUBDIVISION The Landing BLOCK / SECTION LOT 30 LOT AREA 1.59 acres SITE CLASS. PS DESIGN FLOW 360 L.T.A.R. .25

Septic Tank: 1000 Gallons; STB 875 Date 8-17-98
Pump Tank: 1000 Gallons; PT 47 Date 8-22-98
Pump Make: Zoeller Model 163 Serial No. LR4y384
Nitrification Field: No Fields 1 Square Feet 1080 Linear Feet 360
No Lines 6 Trench Width 36" Max Trench Bottom Depth 36" Gravel Depth N/A

☑ New System ☐ Repair System Type: I, II, (III) IV, V, VI
System Description: Pump To 2520 Rel. Syst
Repair System Description: " " " "
Maintenance Agreement Required: ☐ Yes ☑ No


☑ House/Mod. Home No. Bedrooms 3
☐ Mobile Home No. Bathrooms 2
☐ Business No. Employees
☐ Other
☐ Slab ☑ Crawl Space ☐ Basement w/plumbing ☐ Basement wo/plumbing

Water Supply: ☐ Individual ☑ Public ☐ Community

Comments:/Conditions:

Comments:/Conditions: Inspected Drain lines S.T. P.T. Pressure Test 10-6-98 Jcm

INITIAL SITE SKETCH

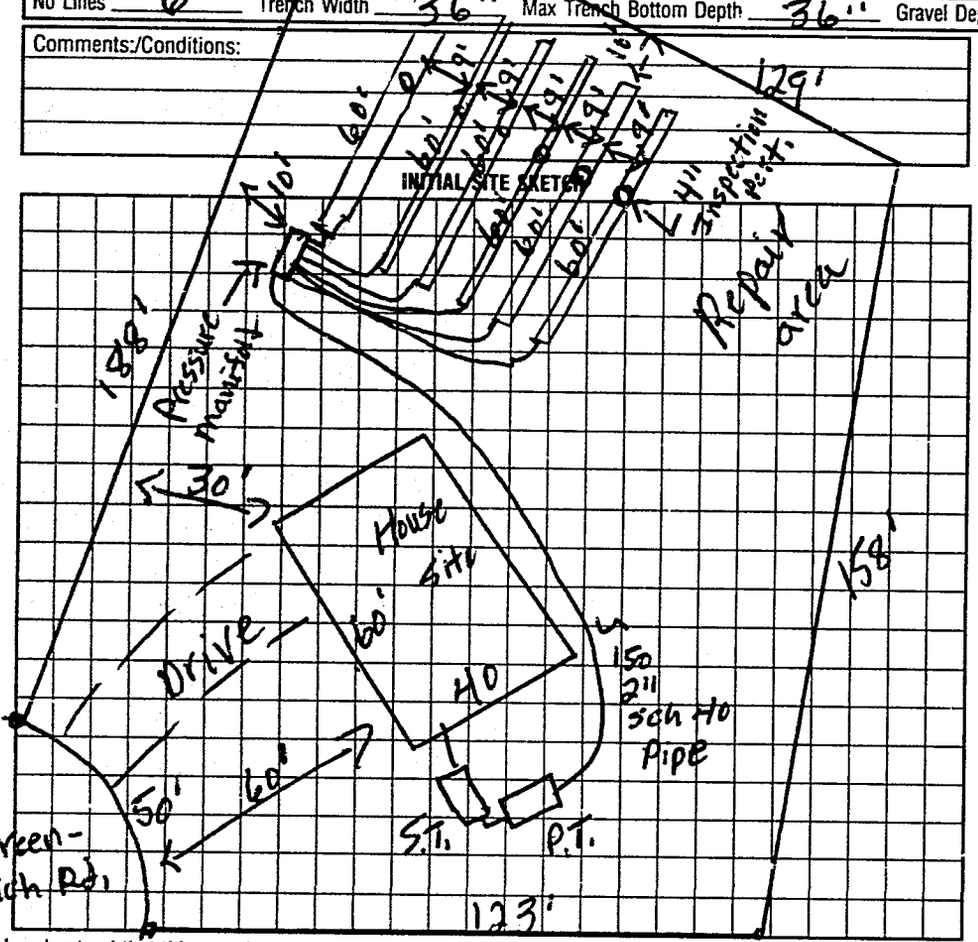

AS BUILT SKETCH

Inspected wiring & Elec. Box

(Replace Lid over Riser)

I understand that this permit can be suspended or revoked if any false information is supplied toward securing the permit/any unauthorized changes are made to the site/any unauthorized changes are made in the installation of the system. Improvement Permit with plat valid without expiration. Improvement Permit with site plan valid for sixty months. Authorization to Construct is valid for a period equal to that of Improvement Permit – not to exceed ~~sixty~~ months.

Signed: Robert A Collier III date 8-14-98 Installed by: C+W Grading

Improvement Permit by: L. C. Moore date 8-12-98 Operation Permit by: L. C. Moore date 11-6-98

Authorization to Construct by: L. C. Moore date 8-12-98 Existing System Inspection by: date

HEALTH DEPT. COPY: WHITE INSPECTION COPY (FINAL): GREEN OWNER COPY (FINAL): YELLOW INSPECTION COPY (INITIAL): PINK OWNER COPY (INITIAL): GOLD