IREDELL COUNTY HEALTH DEPARTMENT

STATESVILLE 704-878-5305 MOORESVILLE 704-664-5281

IMPROVEMENT PERMIT / AUTHORIZATION TO CONSTRUCT / OPERATION PERMIT / EXISTING SYSTEM INSPECTION

PERMIT# 80125 PIN# 4713866792 DATE 3-30-99

OWNER OR CONTRACTOR Collier Properties PHONE: Business 924 7120 Home

ADDRESS PO Box 366

LOCATION 70 W to Bethlehem to Greenwich to Left

SUBDIVISION Landings BLOCK / SECTION LOT 31 LOT AREA .48 acres SITE CLASS PS DESIGN FLOW 360 L.T.A.R. .3

Septic Tank: 1000 Gallons: STB 1012 Date

Pump Tank: Gallons: P1 Date

Pump Make: Model Serial No.

Nitrification Field: No Fields 1 Square Feet 900 Linear Feet 300

No Lines 4 Trench Width 36" Max Trench Bottom Depth 36" Gravel Depth

☑ New System ☐ Repair System Type: I. II. III IV. V. VI

System Description: Gravity 25% Reduction

Repair System Description: Gravity Pump

Maintenance Agreement Required: ☐ Yes ☑ No

☑ House/Mod. Home ☐ Mobile Home ☐ Business ☐ Other

No. Bedrooms 3 No. Bathrooms 2 No. Employees


Water Supply: ☐ Individual ☑ Public ☐ Community

☐ Slab ☑ Crawl Space ☐ Basement w/plumbing ☐ Basement wo/plumbing


Comments/Conditions:

Comments/Conditions:

INITIAL SITE SKETCH 212'

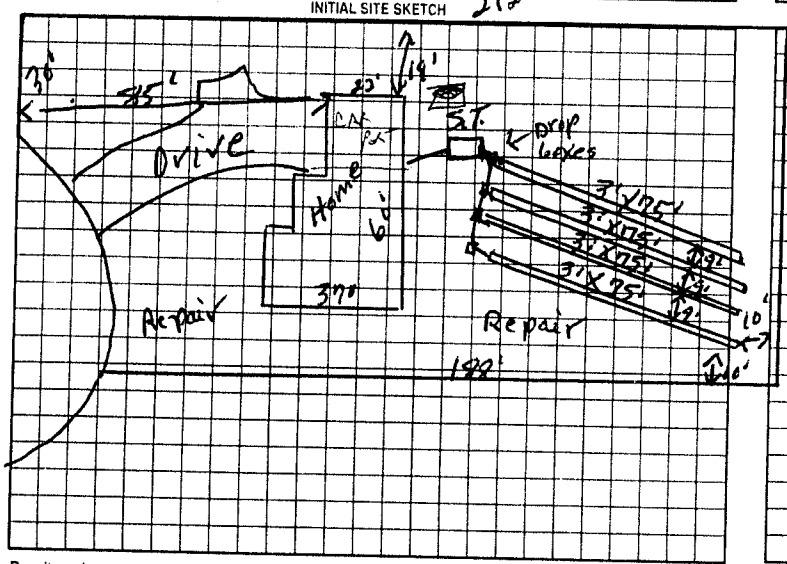

AS BUILT SKETCH

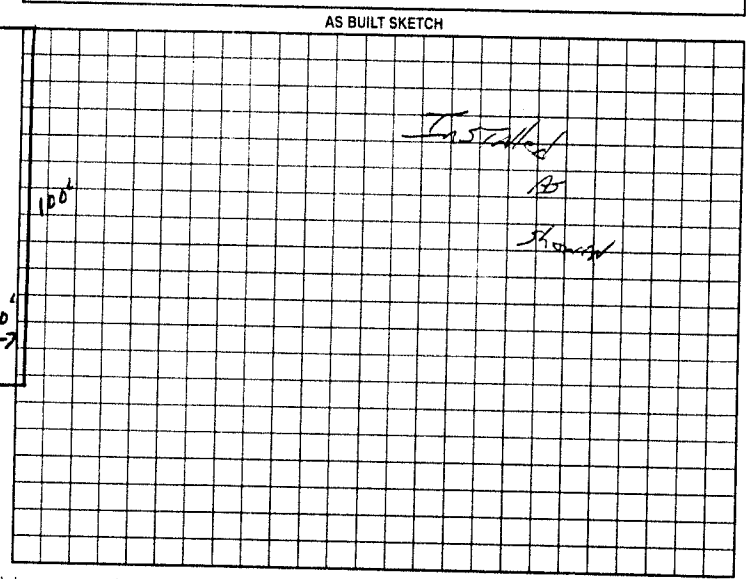

Permit can be suspended or revoked if any false information is supplied toward securing the permit/any unauthorized changes are made to the site/any unauthorized changes are made in the installation of the system. Improvement Permit with plat valid without expiration. Improvement Permit with site plan valid for sixty months. Authorization to Construct is valid for a period equal to that of Improvement Permit – not to exceed sixty months.

Signed: Robert A Collier date 5/6/99

Improvement Permit by: R. C. Moore date 3-30-99

Authorization to Construct by: R. C. Moore date 3-30-99

Installed by: C & W Septic

Operation Permit by: Patch date Sept. 23 99

Existing System Inspection by: date

HEALTH DEPT. COPY WHITE OWNER COPY (FINAL) YELLOW OWNER COPY (INITIAL) PINK