IREDELL COUNTY HEALTH DEPARTMENT

STATESVILLE 704-878-5305 MOORESVILLE 704-664-5281

IMPROVEMENT PERMIT / AUTHORIZATION TO CONSTRUCT / OPERATION PERMIT / EXISTING SYSTEM INSPECTION

PERMIT# 106242 PIN# 4713-86-6119 DATE 6/7/02

OWNER OR CONTRACTOR Ryan Pillard PHONE Business — Home (704) 838-0296

ADDRESS 139 3rd Creek Road Statesville, N.C. 28677

LOCATION Hwy 70 W @ Bethlehem Rd, @ Greenwich Drive, @ Heathrow, @ Dublin Court @ End.

SUBDIVISION The Landings BLOCK / SECTION 3 LOT 68 LOT AREA .330 Ac SITE CLASS PS DESIGN FLOW 360 L.T.A.R. .30 gpd/sf

Septic Tank: 4000 Gallons: STB 794 Date 6-15-02

Pump Tank: — Gallons: PT — Date —

Pump Make: — Model — Serial No —

Nitrification Field: No Fields 1 Square Feet 1200 Linear Feet 400

No Lines 4@100' Trench Width 36" Max Trench Bottom Depth 36" Gravel Depth 12"

[X] New System [ ] Repair System Type I (II) III IV V VI

System Description: Gravity, Conventional

Repair System Description: Gravity, 25% Reduction

Maintenance Agreement Required: [ ] Yes [X] No

[X] House/Mod Home No. Bedrooms 3

[ ] Mobile Home No. Bathrooms 2

[ ] Business No. Employees —

[ ] Other —


[X] Slab [ ] Crawl Space [ ] Basement w/plumbing [ ] Basement wo/plumbing

Water Supply: [X] Individual [ ] Public [ ] Community

Comments/Conditions:

Comments/Conditions — Zabel Filter Installed
— S.T. Marker Installed

INITIAL SITE SKETCH 1" = 50'

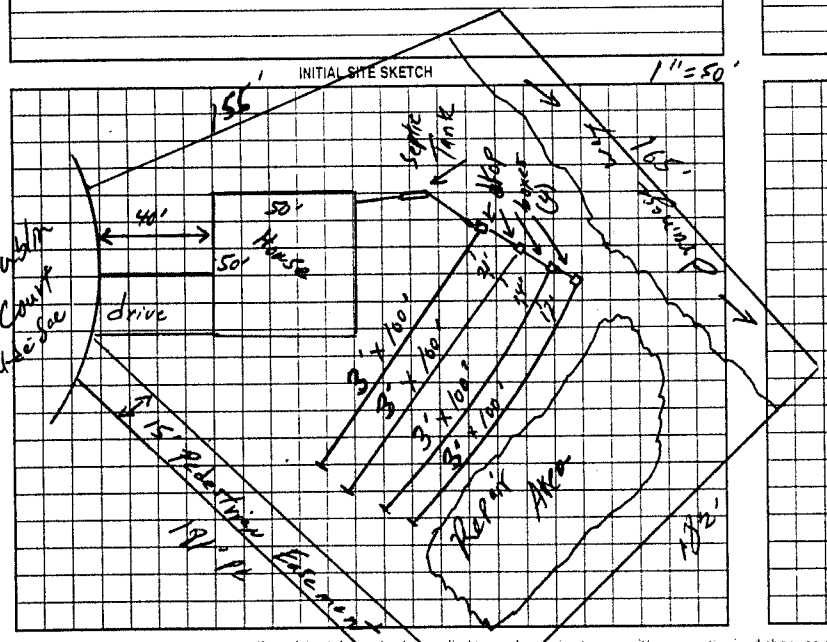

AS BUILT SKETCH

Installed as shown per Initial Site Sketch

Permit can be suspended or revoked if any false information is supplied toward securing the permit/any unauthorized changes are made to the site any unauthorized changes are made in the installation of the system. Improvement Permit with plat valid without expiration. Improvement Permit with site plan valid for sixty months. Authorization to Construct is valid for a period equal to that of Improvement Permit – not to exceed sixty months

Signed: W M Stuart date 6/10/02 Installed by Howard's Backhoe of Denver, N.C.

Improvement Permit by: William O. Johnson date 6/7/02 Operation Permit by: William O. Johnson date 7/5/02

Authorization to Construct by: William O. Johnson date 6/7/02 Existing System Inspection by: — date —

HEALTH DEPT COPY WHITE OWNER COPY (FINAL) YELLOW OWNER COPY (INITIAL) PINK