IREDELL COUNTY HEALTH DEPARTMENT

STATESVILLE 704-878-5305 MOORESVILLE 704-664-5281

IMPROVEMENT PERMIT / AUTHORIZATION TO CONSTRUCT / OPERATION PERMIT / EXISTING SYSTEM INSPECTION

PERMIT# 120624 PIN# 4713-86-7275 87 DATE 5-22-04

OWNER OR CONTRACTOR V. RAY SHORT PHONE: Business 704-202-5568 Home 704-871-1894

ADDRESS P.O. Box 3792, MOORESVILLE, NC 28117

LOCATION US 70 W, TL BETHLEHEM RD TL GREENWICH, TL HEATHROW LANE, TR DUBLIN CT. LOT AT END ON LEFT

SUBDIVISION THE LANDINGS BLOCK / SECTION III LOT 69 LOT AREA 0.44 ACRE SITE CLASS. PS DESIGN FLOW 360' L.T.A.R. 0.30 GPD/FT²

Septic Tank: 1000 Gallons; STB 794 Date 7-23-05

Pump Tank: _____ Gallons; PT _____ Date _____

Pump Make: _____ Model _____ Serial No. _____

Nitrification Field: No Fields 1 Square Feet EQ. FT 1200 Linear Feet 200

No Lines FOUR Trench Width 24" Max Trench Bottom Depth 36" ~~Gravel~~ Depth SAND 24"

☒ New System ☐ Repair System Type: I, II, III, IV, V, VI

System Description: 50% REDUCTION GRAVITY

Repair System Description: 50% REDUCTION, LOW PRESSURE

Maintenance Agreement Required: ☐ Yes ☒ No

☒ House/Mod. Home No. Bedrooms 3

☐ Mobile Home No. Bathrooms 2

☐ Business No. Employees ____

☐ Other _____


☐ Slab ☒ Crawl Space ☐ Basement w/plumbing ☐ Basement wo/plumbing

Water Supply: ☐ Individual ☒ Public ☐ Community

Comments:/Conditions: ① USE ONE EFFLUENT SPLITTER (SUCH AS ZOELLAR "TRU-FLOW") TO ACHIEVE EQUAL DISTRIBUTION. ② INSTALL 50% REDUCTION SYSTEM USING 48 PPBPS PANELS IN FOUR EQUAL LENGTH LINES

Comments:/Conditions: SEPTIC TANK WITH MARKER INSTALLED USING "RED POLY LOK" FILTER

INITIAL SITE SKETCH

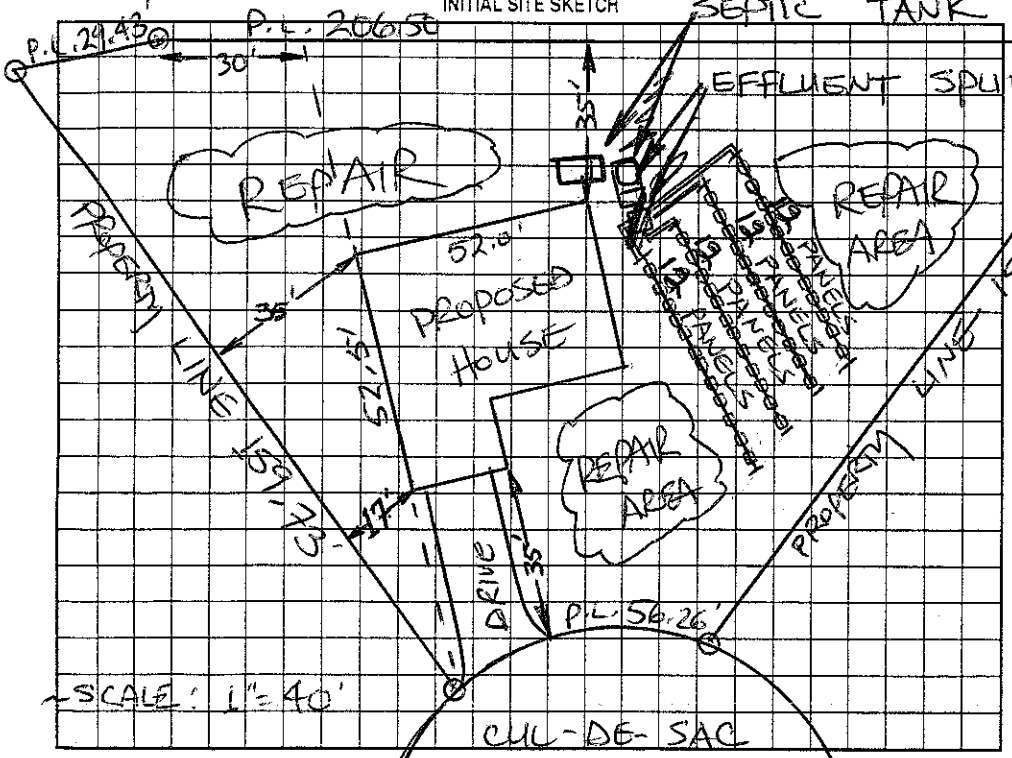

AS BUILT SKETCH

SYSTEM INSTALLED ACCORDING TO INITAL SITE SKETCH

Permit can be suspended or revoked if any false information is supplied toward securing the permit/any unauthorized changes are made to the site/any unauthorized changes are made in the installation of the system. Improvement Permit with plat valid without expiration. Improvement Permit with site plan valid for sixty months. Authorization to Construct is valid for a period equal to that of Improvement Permit – not to exceed sixty months.

Signed: _____ date 5/14/04 Installed by: HOWARD'S BACKHOE

Improvement Permit by: STEVE HEDRICK date 5-22-04 Operation Permit by: STEVE HEDRICK date 9-9-05

Authorization to Construct by: STEVE HEDRICK date 5-22-04 Existing System Inspection by: _____ date _____

HEALTH DEPT. COPY: WHITE OWNER COPY (FINAL): YELLOW OWNER COPY (INITIAL): PINK