IREDELL COUNTY HEALTH DEPARTMENT

STATESVILLE 704-878-5305 MOORESVILLE 704-664-5281

IMPROVEMENT PERMIT / AUTHORIZATION TO CONSTRUCT / OPERATION PERMIT / EXISTING SYSTEM INSPECTION

PERMIT# 108554 PIN# 4713-86-8410 DATE 9/6/02

OWNER OR CONTRACTOR Mid-Atlantic Custom Builders Inc PHONE: Business (704) 202-5568 Home —

ADDRESS P.O. Box 3792 Mooresville, N.C. 28117

LOCATION OMR, (L) Bethlehem Rd, (R) Greenwich Drive, (L) Heathrow, (R) Dublin Ct on left at End.

SUBDIVISION The Landings BLOCK / SECTION 3 LOT 70 LOT AREA .590 Ac SITE CLASS. PS DESIGN FLOW 360 L.T.A.R.

Septic Tank: 1000 Gallons; STB 794 Date 07/08/02

Pump Tank: ______ Gallons; PT ______ Date ______

Pump Make: ______ Model ______ Serial No. ______

Nitrification Field: No Fields 1 Square Feet equiv. to 1200 Linear Feet 300

No Lines 5 Trench Width 36" Max Trench Bottom Depth 36" Gravel Depth NA

[X] New System ☐ Repair System Type: I, II, (III), IV, V, VI

System Description: Gravity, 25% Reduction

Repair System Description: Pump, ~~[illegible]~~ LPP ~~[illegible]~~

Maintenance Agreement Required: ☐ Yes [X] No

☐ Slab [X] Crawl Space ☐ Basement w/plumbing ☐ Basement wo/plumbing

[X] House/Mod. Home ☐ Mobile Home ☐ Business ☐ Other


No. Bedrooms 3 No. Bathrooms 2 No. Employees ______

Water Supply: ☐ Individual [X] Public ☐ Community


Comments/Conditions: (1) Install 25% Reduction System on Contour (2) Maintain proper setbacks

Comments/Conditions: - SEPTIC TANK INSTALLED USING TANK MARKER + ZEBEL FILTER
* SYSTEM INSTALLED DURING PERIOD OF MOIST SOIL CONDITIONS.

INITIAL SITE SKETCH Scale 1" = 60'

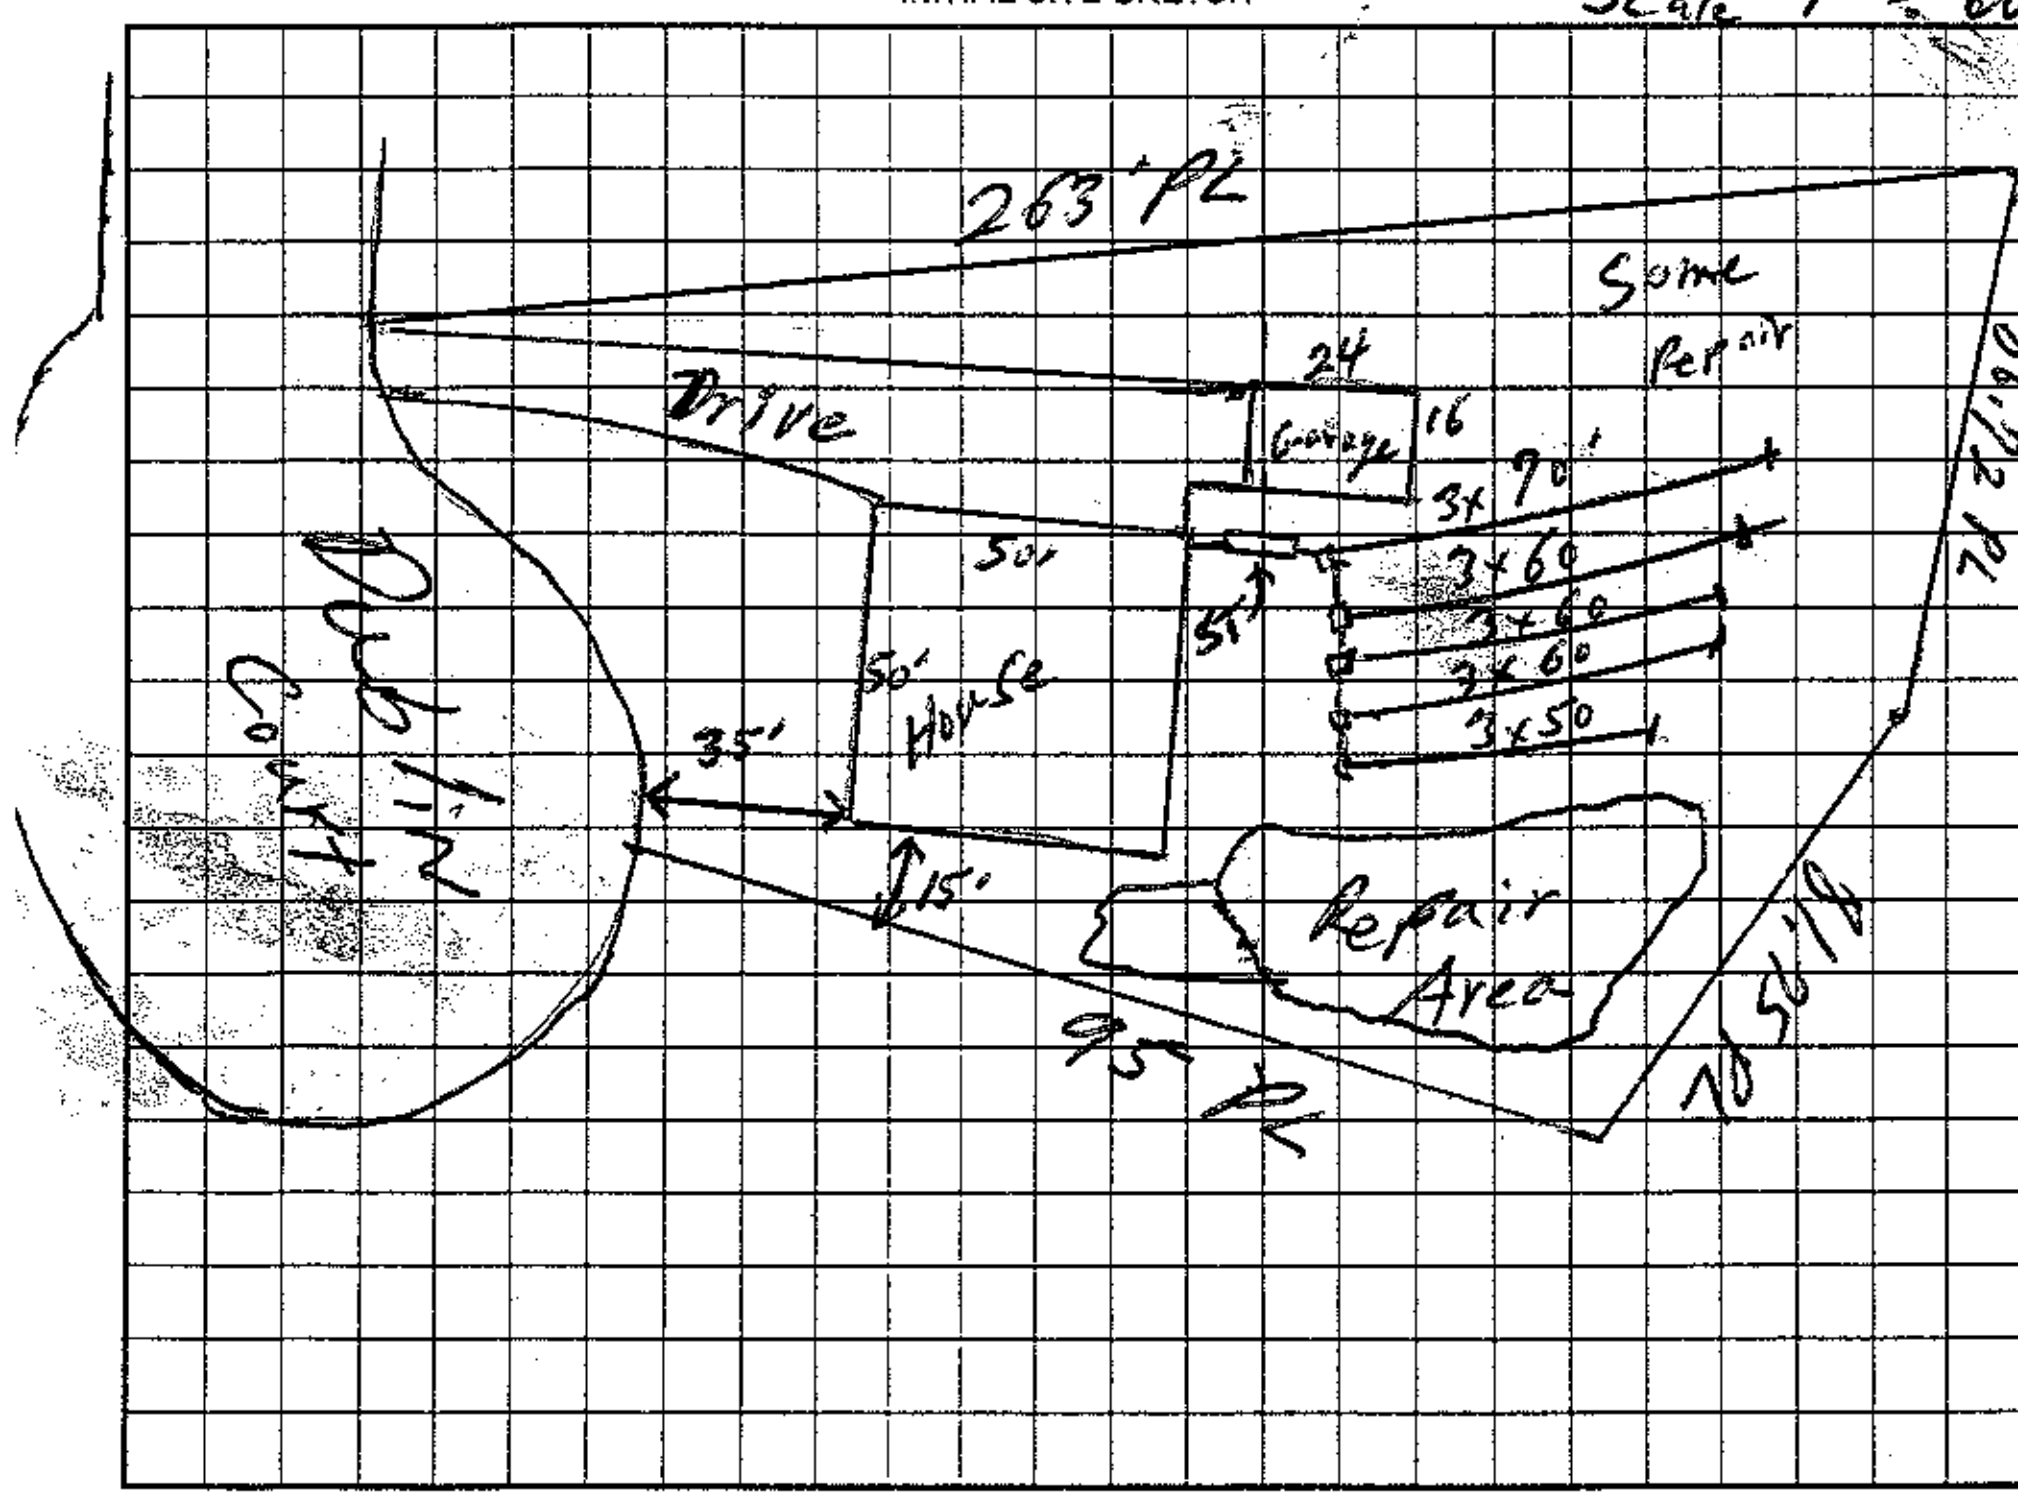

AS BUILT SKETCH

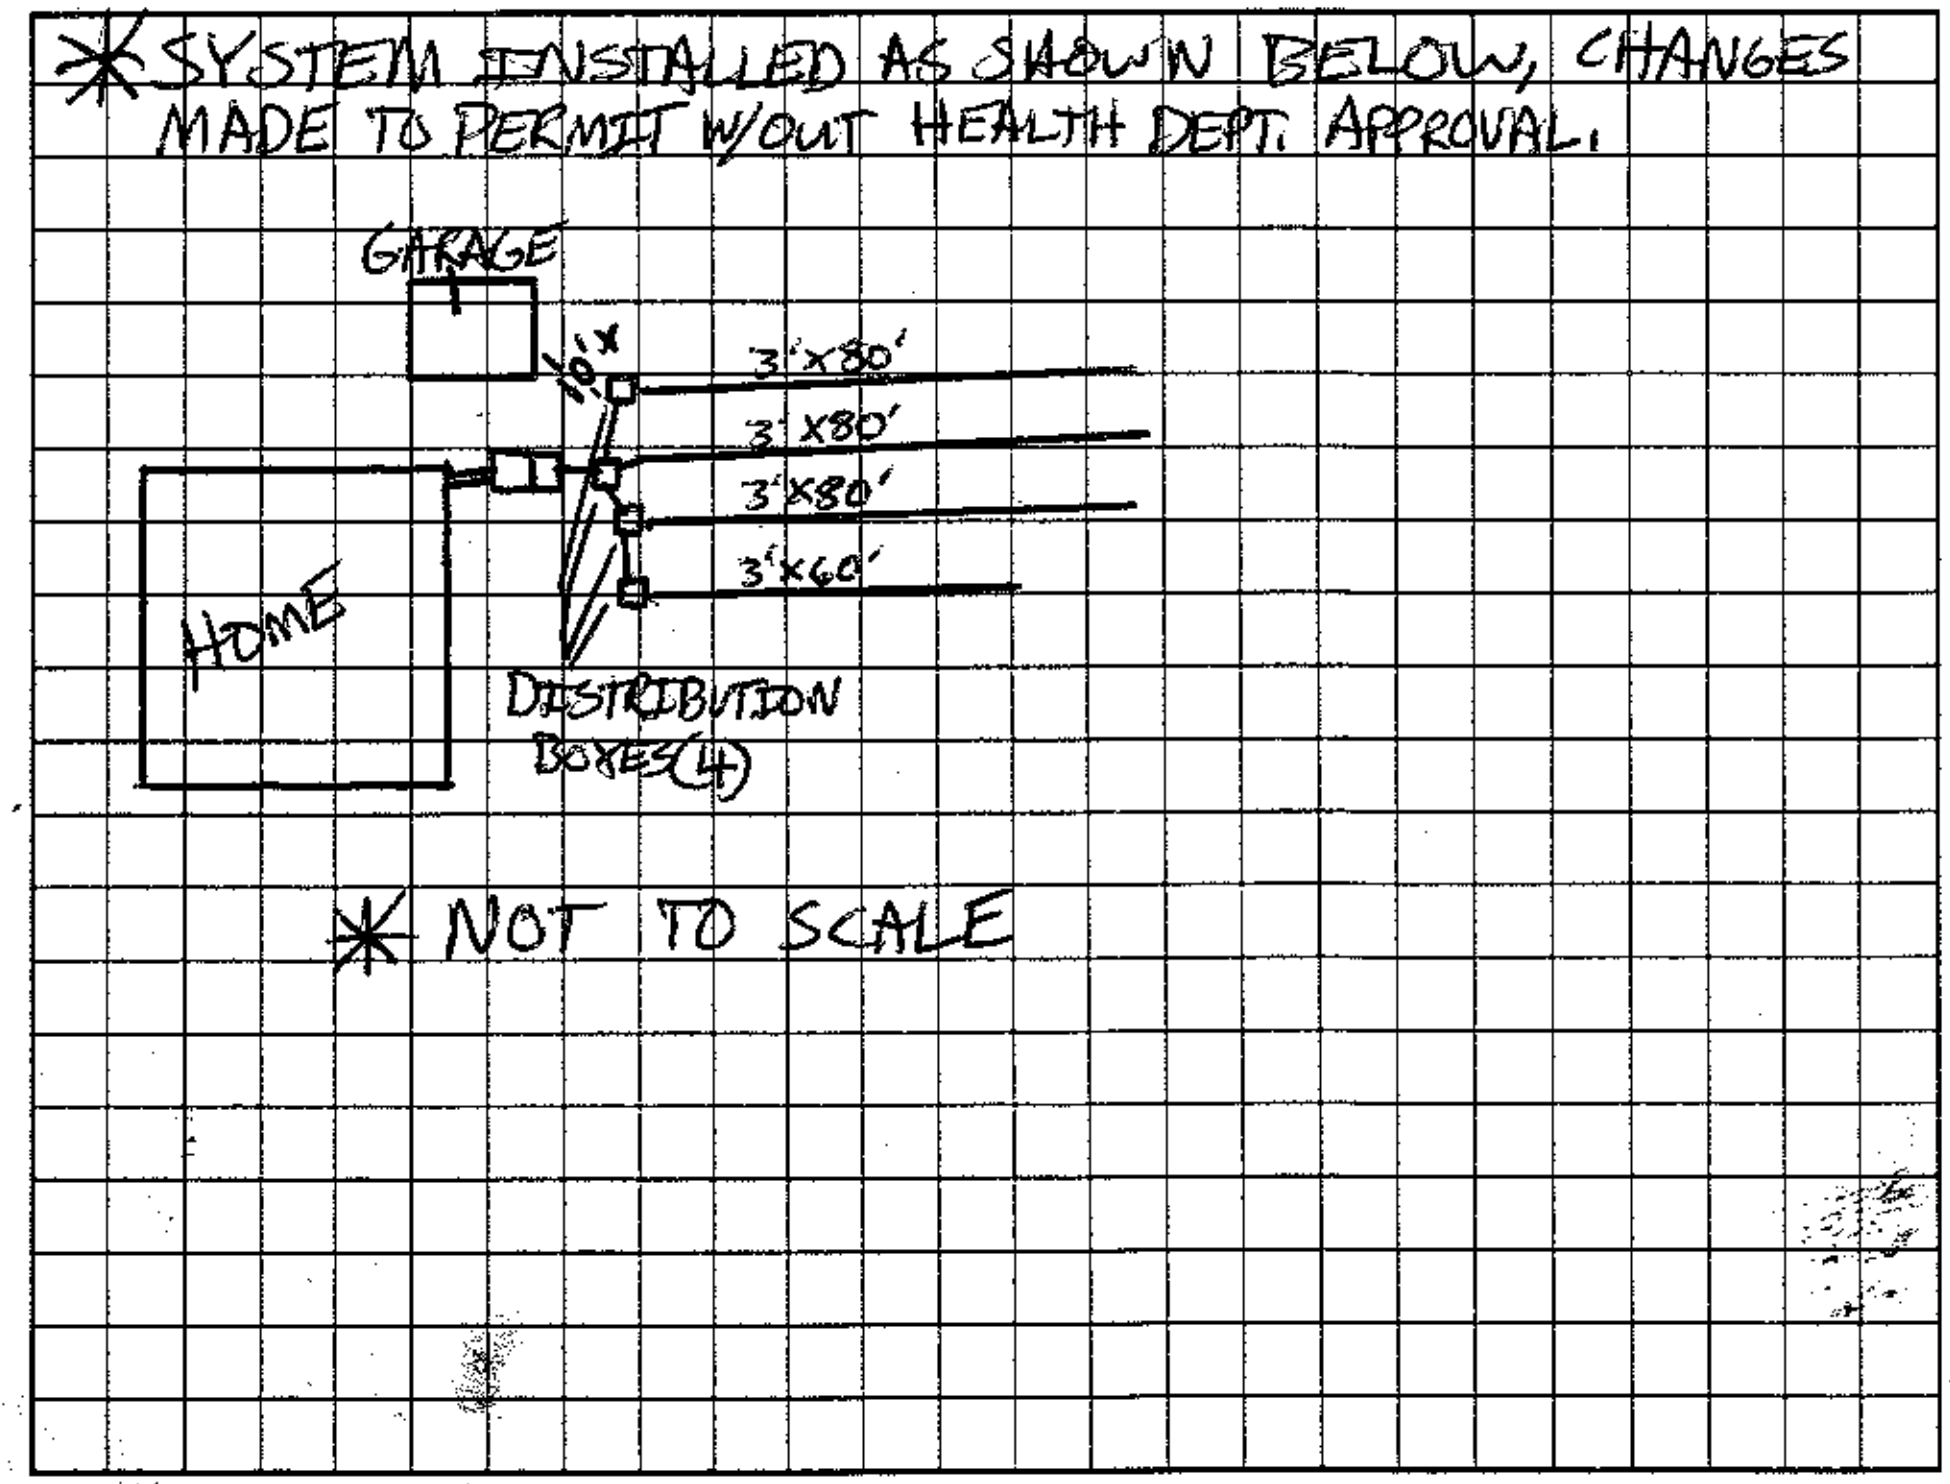

Permit can be suspended or revoked if any false information is supplied toward securing the permit/any unauthorized changes are made to the site/any unauthorized changes are made in the installation of the system. Improvement Permit with plat valid without expiration. Improvement Permit with site plan valid for sixty months. Authorization to Construct is valid for a period equal to that of Improvement Permit – not to exceed sixty months.

Signed: [signature] date 9/12/02

Improvement Permit by: William O. Johnson date 9/6/02

Authorization to Construct by: William O. Johnson date 9/6/02

Installed by: HOWARD'S BACK HOE, Garrett Howard 01/21/03

Operation Permit by: Patrick Mitchell date 01/22/03

Existing System Inspection by: ______ date ______

HEALTH DEPT. COPY: WHITE OWNER COPY (FINAL): YELLOW OWNER COPY (INITIAL): PINK