THIS PERMIT VOIDS PREVIOUS ISSUED 3-1-02

IREDELL COUNTY HEALTH DEPARTMENT

STATESVILLE 704-878-5305 (C) MOORESVILLE 704-664-5281

IMPROVEMENT PERMIT / AUTHORIZATION TO CONSTRUCT / OPERATION PERMIT / EXISTING SYSTEM INSPECTION

PERMIT# 105085 PIN# 4713-86-8960 DATE 5-11-02

OWNER OR CONTRACTOR COLLIER PROPERTIES PHONE Business 704-201-4993 Home 704-924-7120

ADDRESS P.O. BOX 5806, STATESVILLE, NC 28687

LOCATION US 70 WEST, TL BETHLEHEM RD, TL GREENWICH DR, TL HEATHROW LN, TR DUBLIN COURT, 5TH LOT ON LEFT

SUBDIVISION THE LANDINGS BLOCK / SECTION III LOT 75 LOT AREA 0.50 ACRE SITE CLASS PS DESIGN FLOW 480 L.T.A.R. 0.30 GAD/FT²

Septic Tank: 1000 Gallons: STB 1007 Date 3-21-02
Pump Tank: Gallons: PT Date
Pump Make: Model Serial No
Nitrification Field: No Fields 1 Square Feet Equiv 1600 Linear Feet 475
No Lines FIVE Trench Width 36" Max Trench Bottom Depth 36" Gravel Depth 12" N/A

✓ New System ☐ Repair System Type: I II (III) IV V VI
System Description: CONV, 25% REDUCTION GEN.
Repair System Description: 50% REDUCTION, LOW PRESSURE
Maintenance Agreement Required: ☐ Yes ✓ No
~~Slab~~ ~~Crawl Space~~ ☐ Basement w/plumbing ☐ Basement wo/plumbing


✓ House/Mod Home No Bedrooms 4
☐ Mobile Home No Bathrooms 2½
☐ Business No Employees
☐ Other

Water Supply: ☐ Individual ● Public ☐ Community

Comments:/Conditions:

Comments:/Conditions: SEPTIC TANK WITH MARKER INSTALLED USING "POLYLOK" FILTER

INITIAL SITE SKETCH

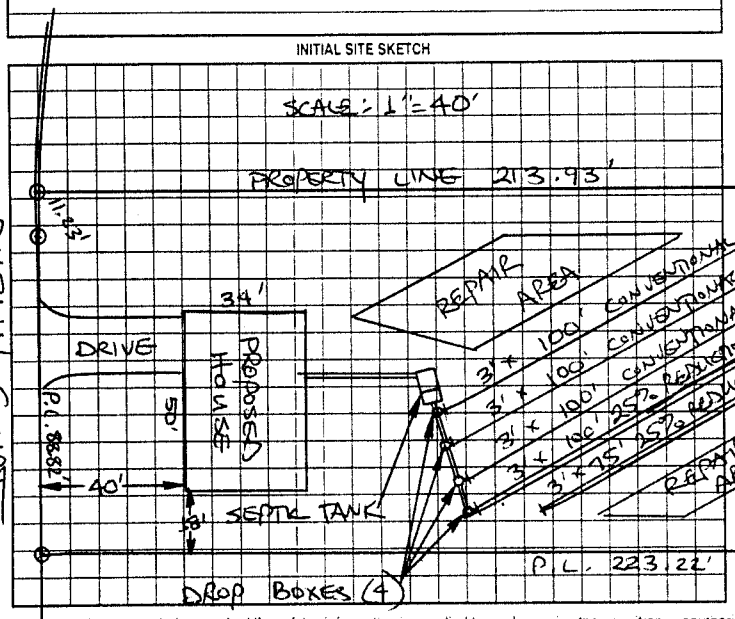

AS BUILT SKETCH

SYSTEM INSTALLED ACCORDING TO INITIAL SITE SKETCH

Permit can be suspended or revoked if any false information is supplied toward securing the permit any unauthorized changes are made to the site any unauthorized changes are made in the installation of the system. Improvement Permit with plat valid without expiration. Improvement Permit with site plan valid for sixty months. Authorization to Construct is valid for a period equal to that of Improvement Permit - not to exceed sixty months

Signed: _____ date _____ Installed by STATESVILLE BACKHOE

Improvement Permit by: STEVE HEDRICK date 5-11-02 Operation Permit by: STEVE HEDRICK date 6-4-02

Authorization to Construct by: STEVE HEDRICK date 5-11-02 Existing System Inspection by: _____ date _____

HEALTH DEPT COPY WHITE OWNER COPY (FINAL) YELLOW OWNER COPY (INITIAL) PINK