IREDELL COUNTY HEALTH DEPARTMENT

STATESVILLE 704-878-5305 MOORESVILLE 704-664-5281 (ar)

IMPROVEMENT PERMIT / AUTHORIZATION TO CONSTRUCT / OPERATION PERMIT / EXISTING SYSTEM INSPECTION

PERMIT # 157624 PIN # 4713870403 DATE 7/27/09

OWNER or APPLICANT HARRY DAVIS PHONE: Business 704-682-9649 Home:

OWNER or APPLICANT ADDRESS 115 GATWICK CT Statesville NC 28677

LOCATION / DIRECTIONS 70 WEST (L) BETHLEHEM (L) LANDINGS / Greenwich LN (R) GATWICK ATEND

SUBDIVISION THE LANDINGS BLOCK / SECTION LOT # 15 LOT AREA .97 DESIGN FLOW 4 L.T.A.R. .133

Septic Tank 1000 Gallons: STB 1012 Date 1-12-99

Pump Tank Gallons: P T Date

Pump Make Model Serial #

Nitrification Field No Fields 1 No Lines 4 Linear Feet [redacted] 450'

Trench Width 36" Max. Trench Bottom Depth 36" Gravel Depth ?

☒ New System ☐ Repair ☐ Expansion System Type I II III IV V VI

System Description: Gravity Conv

Repair System Description: Gravity 25%

Maintenance Agreement Required ☐ YES ☒ NO

☒ GRAVITY ☐ PRESSURE

☒ Residence No. Bedrooms 4

☐ Business No. Persons

☐ Other No. Employees

☐ Slab ☐ Crawl Space

☒ Basement w/plumbing ☐ Basement w/o plumbing


Water Supply: ☐ Private ☒ Public ☐ Community

Comments / Conditions: (1) This is an existing system check for a new DECK 10' x 17' 10" by 14" in same location as old one. (2) System was properly functioning at time of check.

Comments / Conditions

INITIAL SITE SKETCH

AS BUILT SKETCH

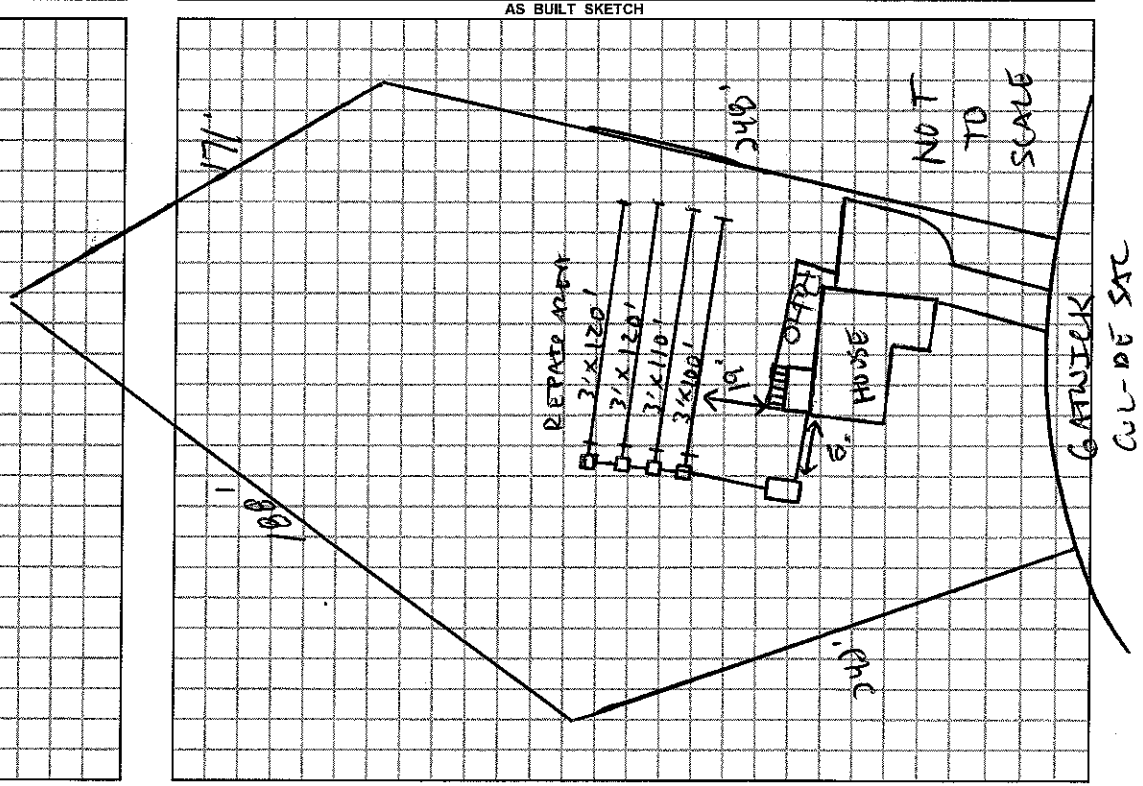

Permit can be suspended or revoked if any false information is supplied toward securing the permit / any unauthorized changes are made to the site / any unauthorized changes are made in the installation of the system.

☐ *IMPROVEMENT PERMIT w / plat valid without expiration.* ☐ *IMPROVEMENT PERMIT w / site plan valid for 60 mos.* ☐ *AUTHORIZATION TO CONSTRUCT valid for period equal to IMPROVEMENT PERMIT-not to exceed 60 mo.*

Owner / Applicant Signature: Harry R. Davis Date 7/28/09

Improvement Permit by: Date

Authorization to Construct by: Date

YOU SHOULD CONTACT A LOCATOR SERVICE PRIOR TO ANY EXCAVATION.

Installed by:

Operation Permit by: Date:

Existing System Inspected by: Date: 7/27/09

WHITE COPY Environmental Health YELLOW COPY (Final) Owner / Applicant PINK COPY (Initial) Owner / Applicant