IREDELL COUNTY HEALTH DEPARTMENT

STATESVILLE 704-878-5305 MOORESVILLE 704-664-5281

IMPROVEMENT PERMIT / AUTHORIZATION TO CONSTRUCT / OPERATION PERMIT / EXISTING SYSTEM INSPECTION

PERMIT# 75338 PIN# 4713 86 6792 DATE 9-18-98

OWNER OR CONTRACTOR Collier Properties PHONE: Business 924 7120 Home

ADDRESS PO BOX 5806 Statesville, N.C. 28677

LOCATION 70 W TL Bethlehem Go 1 1/2 mi TL Greenwich TR Gothwick on left

SUBDIVISION Lansing BLOCK / SECTION LOT 15 LOT AREA 196 acres SITE CLASS PS DESIGN FLOW 480 L.T.A.R. .33

Septic Tank: 1000 Gallons; STB 1012 Date 1-12-99 CONV

Pump Tank: Gallons; PT Date

Pump Make: Model Serial No.

Nitrification Field: No Fields 1 Square Feet 1350 Linear Feet 450

No Lines 4 Trench Width 36" Max Trench Bottom Depth 76" Gravel Depth N/A

☑ New System ☐ Repair System Type: I, II, III, IV, V, VI

System Description: ~~Gravity 36" Rock~~

Repair System Description: Graywater 25 Rock

Maintenance Agreement Required: ☐ Yes ☑ No

☑ House/Mod. Home No. Bedrooms ~~3~~ 4

☐ Mobile Home No. Bathrooms 3

☐ Business No. Employees

☐ Other


☐ Slab ☐ Crawl Space ☐ Basement w/plumbing ☐ Basement wo/plumbing

Water Supply: ☐ Individual ☑ Public ☐ Community


Comments:/Conditions:

Comments:/Conditions:

INITIAL SITE SKETCH

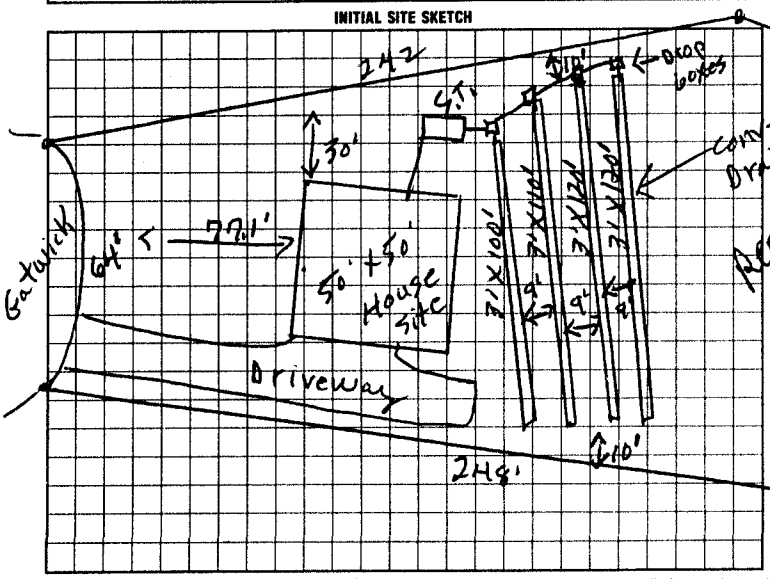

AS BUILT SKETCH

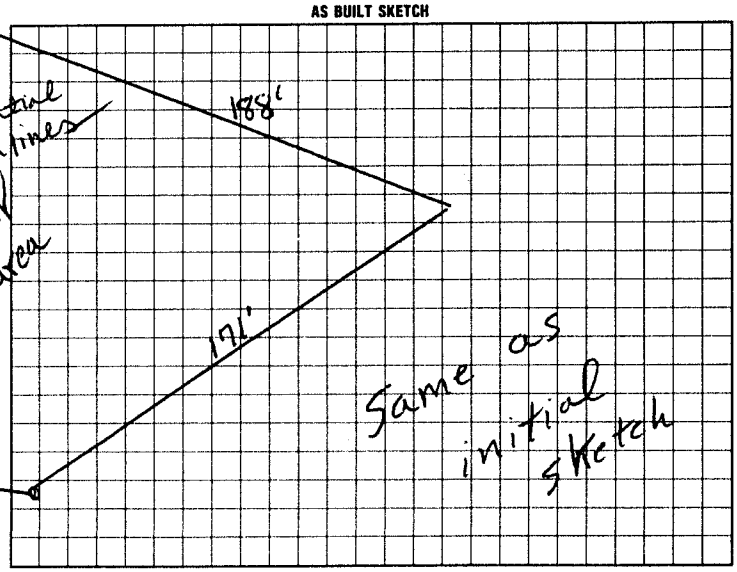

I understand that this permit can be suspended or revoked if any false information is supplied toward securing the permit/any unauthorized changes are made to the site/any unauthorized changes are made in the installation of the system. Improvement Permit with plat valid without expiration. Improvement Permit with site plan valid for sixty months. Authorization to Construct is valid for a period equal to that of Improvement Permit – not to exceed sixty months.

Signed: Robert A Collier II date 9-29-98 Installed by: C+W

Improvement Permit by: R.C. moore date 9-18-98 Operation Permit by: R.C. moore date 3-24-99

Authorization to Construct by: R.C. moore date 9-18-98 Existing System Inspection by: date

HEALTH DEPT. COPY: WHITE INSPECTION COPY (FINAL): GREEN OWNER COPY (FINAL) YELLOW INSPECTION COPY (INITIAL) PINK OWNER COPY (INITIAL): GOLD