IREDELL COUNTY HEALTH DEPARTMENT

STATESVILLE 704-878-5305 (C) MOORESVILLE 704-664-5281

IMPROVEMENT PERMIT / AUTHORIZATION TO CONSTRUCT / OPERATION PERMIT / EXISTING SYSTEM INSPECTION

(C)

PERMIT# 142923 PIN# 4713-87-0792 DATE 6-2-07

OWNER OR APPLICANT ALBERT JUSTICE PHONE: Business Home 704-872-1150

ADDRESS 434 BETHLEHEM ROAD, STATESVILLE, NC 28677

LOCATION US 70 WEST, TL BETHLEHEM ROAD, ~1.0 MILE ON LEFT AT BOX #434

SUBDIVISION BLOCK / SECTION LOT LOT AREA 2.04 ACRES SITE CLASS. P3 DESIGN FLOW 360 L.T.A.R. 0.35 GPD/FT2

Septic Tank: EXISTING Gallons; STB Date

Pump Tank: Gallons; PT Date

Pump Make: Model EQT Serial No.

Nitrification Field: No Fields 1 Square Feet 342 Linear Feet 84

No Lines TWO Trench Width 36" Max Trench Bottom Depth 36" Gravel Depth N/A

☐ New System ☐ Repair ☑ Expansion System Type: I (II) III IV V VI

System Description: 25% REDUCTION GRAVITY

Repair System Description: 25% REDUCTION, GRAVITY

Maintenance Agreement Required: ☑ Yes ☐ No

☑ House/Mod. Home No. Bedrooms 3

☐ Mobile Home No. Persons

☐ Business No. Employees

☐ Other


Water Supply: ☑ Individual ☐ Public ☐ Community

☑ Gravity ☐ Pressure ☐ Slab ☑ Crawl Space ☐ Basement w/plumbing ☐ Basement wo/plumbing


Comments:/Conditions: EXPAND EXISTING SYSTEM BY ADDING 84 FEET 25% REDUCTION SYSTEM ON CONTOUR AS FLAGGED.

Comments:/Conditions:

INITIAL SITE SKETCH ~ SCALE : 1" = 50'

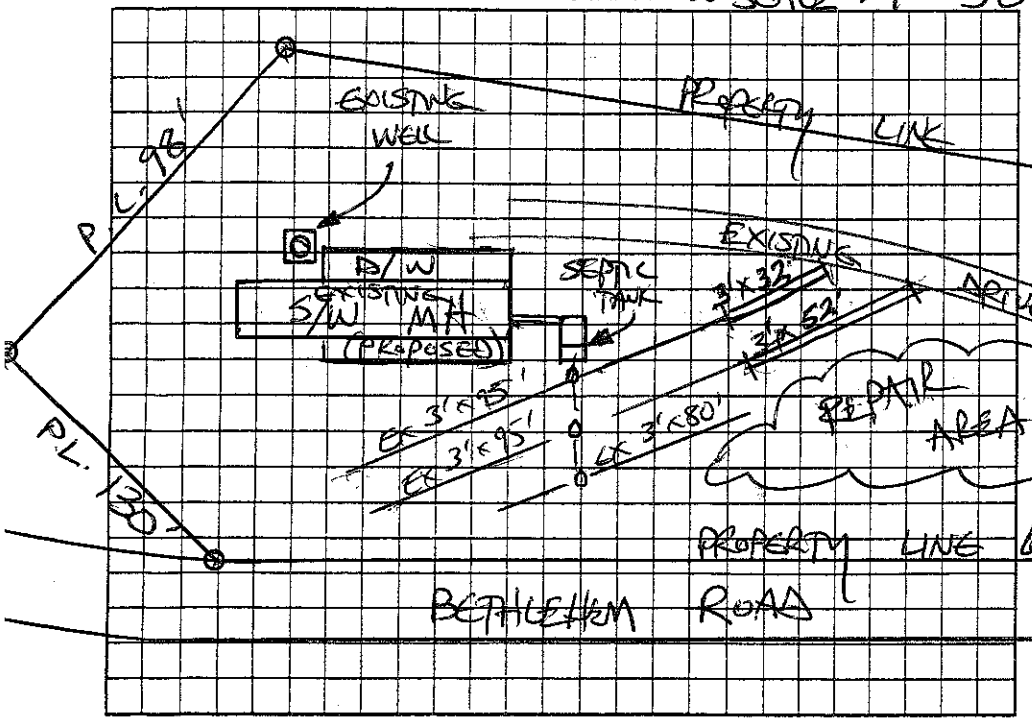

AS BUILT SKETCH

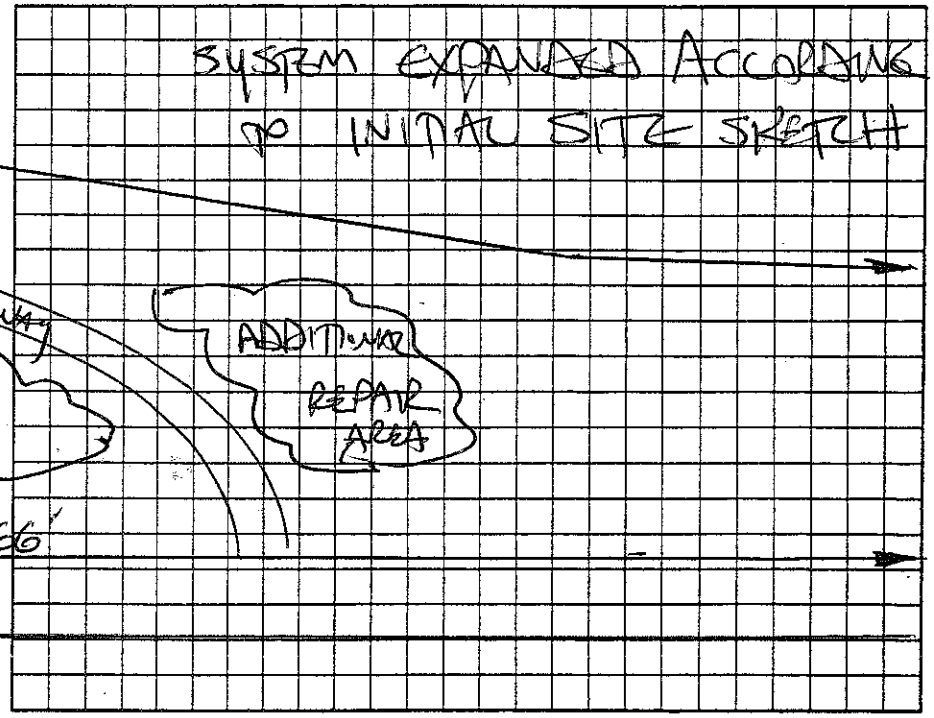

Permit can be suspended or revoked if any false information is supplied toward securing the permit/any unauthorized changes are made to the site/any unauthorized changes are made in the installation of the system. Improvement Permit with plat valid without expiration ☐ Improvement Permit with site plan valid for sixty months ☑ Authorization to Construct is valid for a period equal to that of Improvement Permit – not to exceed sixty months.

Signed: date 6/2/07 Installed by: DALE WINGLER

Improvement Permit by: STEVE HENDRICK date 6-2-07 Operation Permit by: STEVE HENDRICK date 6-19-07

Authorization to Construct by: STEVE HENDRICK date 6-2-07 Existing System Inspection by: date

HEALTH DEPT. COPY: WHITE OWNER COPY (FINAL): YELLOW OWNER COPY (INITIAL): PINK