IREDELL COUNTY HEALTH DEPARTMENT

STATESVILLE 704-878-5305 MOORESVILLE 704-664-5281

IMPROVEMENT PERMIT / AUTHORIZATION TO CONSTRUCT / OPERATION PERMIT / EXISTING SYSTEM INSPECTION

PERMIT# 77564 PIN# 4713 87 3243 DATE 1-11-99

OWNER OR CONTRACTOR Collier Properties PHONE: Business 924-7120 Home

ADDRESS PO Box 5806 Statesville

LOCATION Hwy 70 W TO Bethlehem Rt 1 mi TL Greenwich TR Gatwick on Lft

SUBDIVISION Langley BLOCK / SECTION LOT 16 LOT AREA 1.56 acres SITE CLASS PS DESIGN FLOW 360 L.T.A.R. .13

Septic Tank: 1000 Gallons; STB 825 Date 11-1-98
Pump Tank: Gallons; PT Date
Pump Make: Model Serial No
Nitrification Field: No Fields 1 Square Feet 400 Linear Feet 200
No Lines 2 Trench Width 24" Max Trench Bottom Depth 36" Gravel Depth N/A

☒ New System ☐ Repair System Type: I, II, III, IV, V, VI
System Description: Gravity Panels
Repair System Description:
Maintenance Agreement Required: ☐ Yes ☒ No


☒ House/Mod. Home ☐ Mobile Home ☐ Business ☐ Other
No. Bedrooms 3 No. Bathrooms 2 No. Employees
☐ Slab ☐ Crawl Space ☐ Basement w/plumbing ☐ Basement wo/plumbing

Water Supply: ☐ Individual ☒ Public ☐ Community


Comments/Conditions: Replaces permit issued 11-10-98

Comments/Conditions:

INITIAL SITE SKETCH

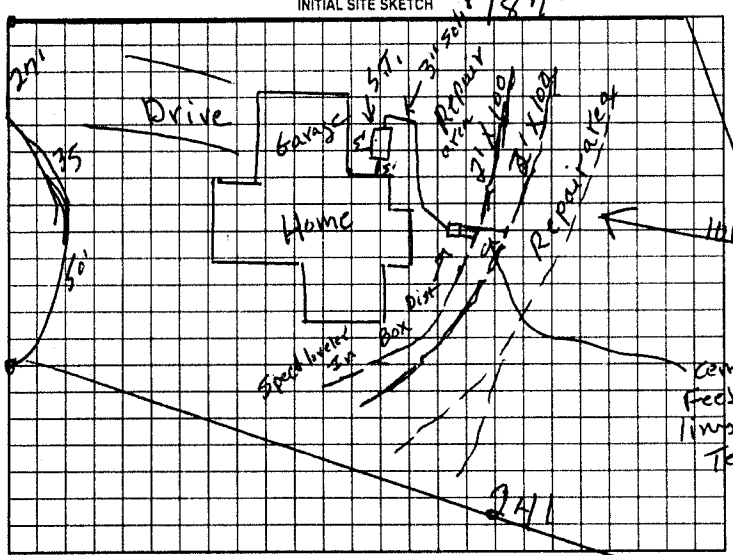

AS BUILT SKETCH

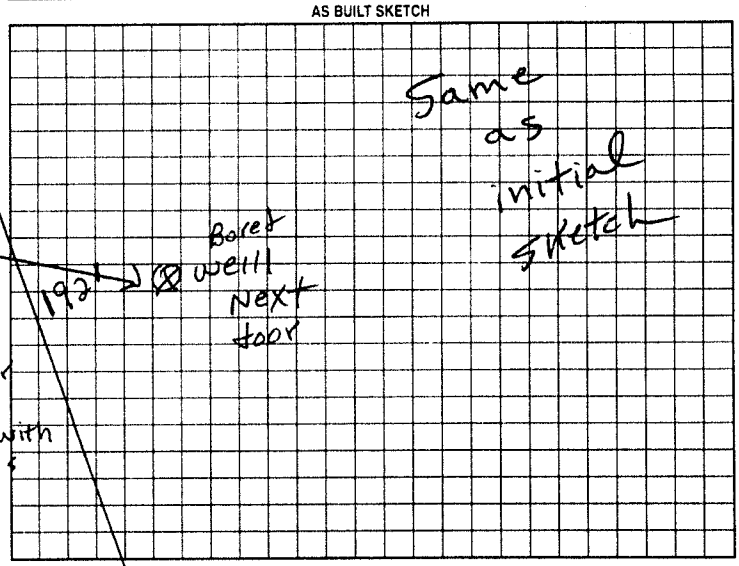

Permit can be suspended or revoked if any false information is supplied toward securing the permit/any unauthorized changes are made to the site/any unauthorized changes are made in the installation of the system. Improvement Permit with plat valid without expiration/ Improvement Permit with site plan valid for sixty months. Authorization to Construct is valid for a period equal to that of Improvement Permit – not to exceed sixty months.

Signed: Robert A Collier date 1-15-99

Improvement Permit by: P. C. Moore date 1-11-99

Authorization to Construct by: P. C. Moore date 1-11-99

Installed by: C+W Grading

Operation Permit by: P. C. Moore date 1-27-99

Existing System Inspection by: date

HEALTH DEPT COPY WHITE OWNER COPY (FINAL) YELLOW OWNER COPY (INITIAL) PINK