IREDELL COUNTY HEALTH DEPARTMENT

STATESVILLE 704-878-5305 MOORESVILLE 704-664-5281

IMPROVEMENT PERMIT / AUTHORIZATION TO CONSTRUCT / OPERATION PERMIT / EXISTING SYSTEM INSPECTION

PERMIT# 77651 PIN# 4713866992 DATE 1-23-97

OWNER OR CONTRACTOR Collier Properties PHONE: Business 924 7120 Home

ADDRESS PO Box 5806 Statesville NC

LOCATION NO West TL Bethlehem Rd 1.25 miles left

SUBDIVISION Landings BLOCK / SECTION LOT 18 LOT AREA 1.56 acres SITE CLASS PS DESIGN FLOW 360 L.T.A.R. 1.3

Septic Tank: 1000 Gallons; STB RST 825 Date 4 18 00
Pump Tank: Gallons; PT Date
Pump Make: Model Serial No.
Nitrification Field: No Fields 1 Square Feet 900 Linear Feet 300
No Lines 4 Trench Width 36" Max Trench Bottom Depth 36"

New System Repair System Type: I II III IV V
System Description: Gravity 25% Red.
Repair System Description: " " "
Maintenance Agreement Required: Yes No

Gravel Depth N/A Slab Crawl Space Basement w/plumbing Basement wo/plumbing


House/Mod. Home No. Bedrooms 3
Mobile Home No. Bathrooms 2½
Business No. Employees
Other

Water Supply: Individual Public Community


Comments/Conditions:

Comments/Conditions:

INITIAL SITE SKETCH

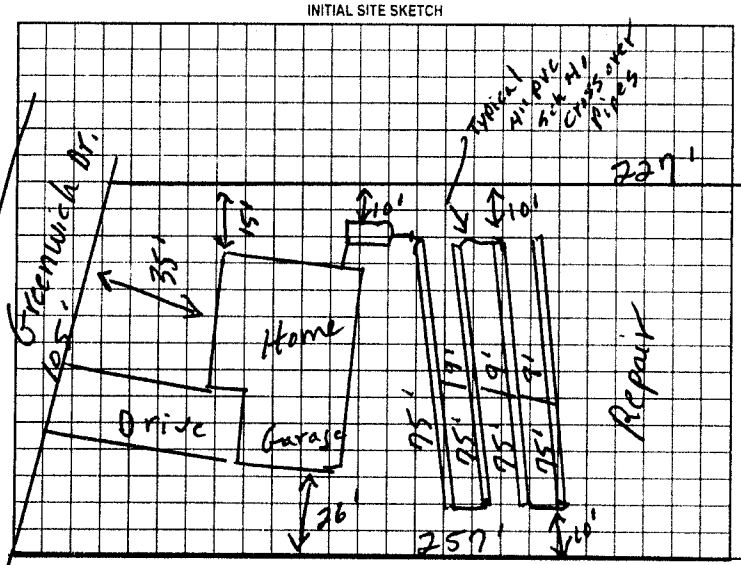

AS BUILT SKETCH

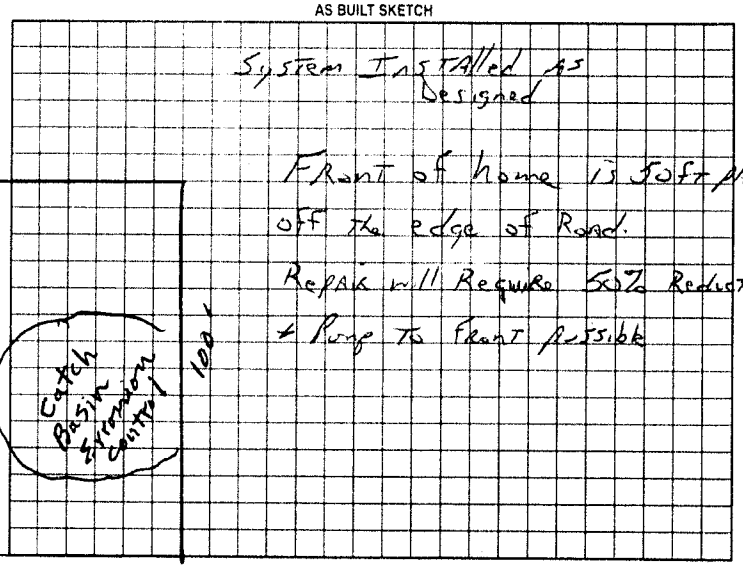

Permit can be suspended or revoked if any false information is supplied toward securing the permit/any unauthorized changes are made to the site/any unauthorized changes are made in the installation of the system. Improvement Permit with plat valid without expiration. Improvement Permit with site plan valid for sixty months. Authorization to Construct is valid for a period equal to that of Improvement Permit - not to exceed sixty months.

Signed: Robert A Collier date 1-27-99 Installed by L & W Grading

Improvement Permit by: R. C. Moore date 1-23-99 Operation Permit by: JC Potter date June 22 2000

Authorization to Construct by: R. C. Moore date 1-23-99 Existing System Inspection by: date

HEALTH DEPT COPY WHITE OWNER COPY (FINAL) YELLOW OWNER COPY (INITIAL) PINK