IREDELL COUNTY HEALTH DEPARTMENT

STATESVILLE 704-878-5305 MOORESVILLE 704-664-5281

IMPROVEMENT PERMIT / AUTHORIZATION TO CONSTRUCT / OPERATION PERMIT / EXISTING SYSTEM INSPECTION

PERMIT# 76345 PIN# 4713 86 6792 DATE 1-11-99

OWNER OR CONTRACTOR Collier properties PHONE: Business Home

ADDRESS PO Box 366

LOCATION NOW TL Bethlehem Rd TL Greenwich TR Gatwick cul on Rt

SUBDIVISION Landings BLOCK / SECTION LOT 13 LOT AREA 1.46 acres SITE CLASS PS DESIGN FLOW 360 L.T.A.R. 1.3

Septic Tank: 1000 Gallons; STB 825 Date 11-4-98
Pump Tank: Gallons; PT Date
Pump Make: Model Serial No.
Nitrification Field: No Fields 1 Square Feet 900 Linear Feet 300
No Lines 4 Trench Width 36" Max Trench Bottom Depth 36" Gravel Depth N/A

☑ New System ☐ Repair System Type: I, II, III, IV, V, VI
System Description: 2590 Rock
Repair System Description: Pamlico Gravity
Maintenance Agreement Required: ☐ Yes ☑ No

☐ Slab ☑ Crawl Space ☐ Basement w/plumbing ☐ Basement wo/plumbing


☑ House/Mod. Home No. Bedrooms 3
☐ Mobile Home No. Bathrooms 2
☐ Business No. Employees
☐ Other

Water Supply: ☐ Individual ☐ Public ☐ Community

Comments/Conditions: Replaces Permit issued 9-24-98

Comments/Conditions:

INITIAL SITE SKETCH

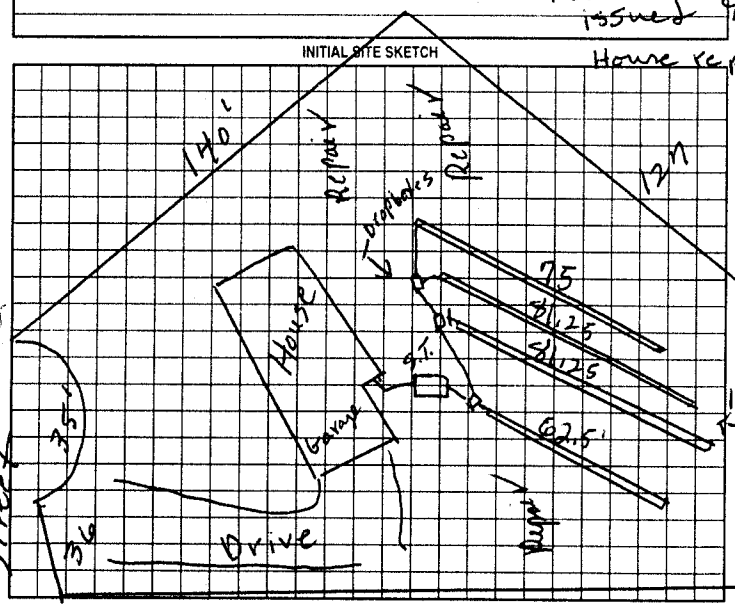

AS BUILT SKETCH

Same as initial sketch

Permit can be suspended or revoked if any false information is supplied toward securing the permit/any unauthorized changes are made to the site/any unauthorized changes are made in the installation of the system. Improvement Permit with plat valid without expiration. Improvement Permit with site plan valid for sixty months. Authorization to Construct is valid for a period equal to that of Improvement Permit – not to exceed sixty months.

Signed: [signature] date 1-12-99

Improvement Permit by: P.C. Moore date 1-11-99

Authorization to Construct by: P.C. Moore date 1-11-99

Installed by: C+W Grading + S.T.

Operation Permit by: P.C. Moore date 1-13-99

Existing System Inspection by: date

HEALTH DEPT. COPY: WHITE OWNER COPY (FINAL): YELLOW OWNER COPY (INITIAL): PINK