IREDELL COUNTY HEALTH DEPARTMENT

STATESVILLE 704-878-5305 MOORESVILLE 704-664-5281

IMPROVEMENT PERMIT / AUTHORIZATION TO CONSTRUCT / OPERATION PERMIT / EXISTING SYSTEM INSPECTION

PERMIT# 79018 PIN# 4713866792 DATE 1-23-99

OWNER OR CONTRACTOR Collier Properties PHONE: Business 924 7120 Home

ADDRESS PO Box 366

LOCATION 70 W TL Bethlehem TL Greenwich TR Gatwick 1st on L

SUBDIVISION Landing BLOCK / SECTION LOT 17 LOT AREA .5 acr SITE CLASS PS DESIGN FLOW 360 L.T.A.R. .3

Septic Tank: 1000 Gallons: STB 825 Date 1-14-99
Pump Tank: Gallons: PT Date
Pump Make: Model Serial No
Nitrification Field: No Fields 1 Square Feet 900 Linear Feet 300
No Lines 3 Trench Width 36" Max Trench Bottom Depth 36" Gravel Depth N/A

✓ New System Repair System Type: I. II. III. IV. V. VI
System Description: Gravity 25% Red.
Repair System Description:
Maintenance Agreement Required: Yes No


✓ House/Mod. Home No. Bedrooms 3
Mobile Home No. Bathrooms 2 1/2
Business No. Employees
Other
Slab Crawl Space ✓ Basement w/plumbing Basement wo/plumbing

Water Supply: ☐ Individual ☑ Public ☐ Community

Comments/Conditions:

Strut

INITIAL SITE SKETCH

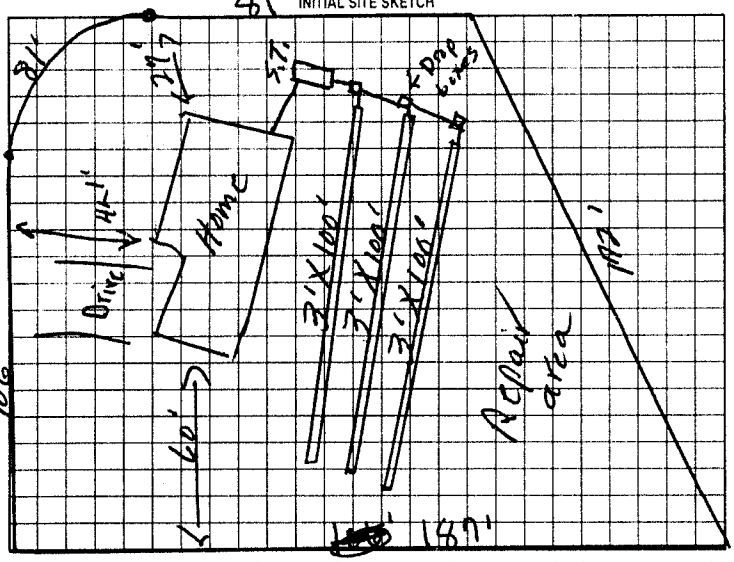

Comments/Conditions

AS BUILT SKETCH

Same as initial sketch

Permit can be suspended or revoked if any false information is supplied toward securing the permit/any unauthorized changes are made to the site/any unauthorized changes are made in the installation of the system. Improvement Permit with plat valid without expiration. Improvement Permit with site plan valid for sixty months. Authorization to Construct is valid for a period equal to that of Improvement Permit - not to exceed sixty months.

Signed: Robert A Collier date 1-27-99 Installed by: Carl

Improvement Permit by: P.C. Moore date 1-23-99 Operation Permit by: P.C. Moore date 3-24-99

Authorization to Construct by: P.C. Moore date 1-23-99 Existing System Inspection by: date

HEALTH DEPT COPY WHITE OWNER COPY (FINAL) YELLOW OWNER COPY (INITIAL) PINK