IREDELL COUNTY HEALTH DEPARTMENT

STATESVILLE 704-878-5305 MOORESVILLE 704-664-5281

IMPROVEMENT PERMIT / AUTHORIZATION TO CONSTRUCT / OPERATION PERMIT / EXISTING SYSTEM INSPECTION

PERMIT# 97509 PIN# 4713874049 DATE 2-4-00

OWNER OR CONTRACTOR Collier Properties PHONE: Business 924-7120 Home

ADDRESS PO Box 5806 Statesville, NC.

LOCATION 70 W to Bethlehem Th Greenwich 400 yds on left

SUBDIVISION Lantings BLOCK / SECTION LOT 37 LOT AREA .47 acres SITE CLASS PS DESIGN FLOW 360 L.T.A.R. .3

Septic Tank: 1000 Gallons; STB 825 Date 3-5-00

Pump Tank: Gallons; PT Date

Pump Make: Model Serial No

Nitrification Field: No Fields 1 Square Feet 900 Linear Feet 300

No Lines 6 Trench Width 36" Max Trench Bottom Depth 36" Gravel Depth N/A

☑ New System ☐ Repair System Type: I. II. III. IV. V. VI

System Description: Gravity 2570 Rehab.

Repair System Description: Pump to 2570 Rehab

Maintenance Agreement Required: ☐ Yes ☑ No

☐ Slab ☑ Crawl Space ☐ Basement w/plumbing ☐ Basement wo/plumbing

☑ House/Mod. Home No. Bedrooms 3

☐ Mobile Home No. Bathrooms 2

☐ Business No. Employees


☐ Other

Water Supply: ☐ Individual ☑ Public ☐ Community


Comments:/Conditions:

Comments /Conditions: 48 chambers installed

INITIAL SITE SKETCH 219'

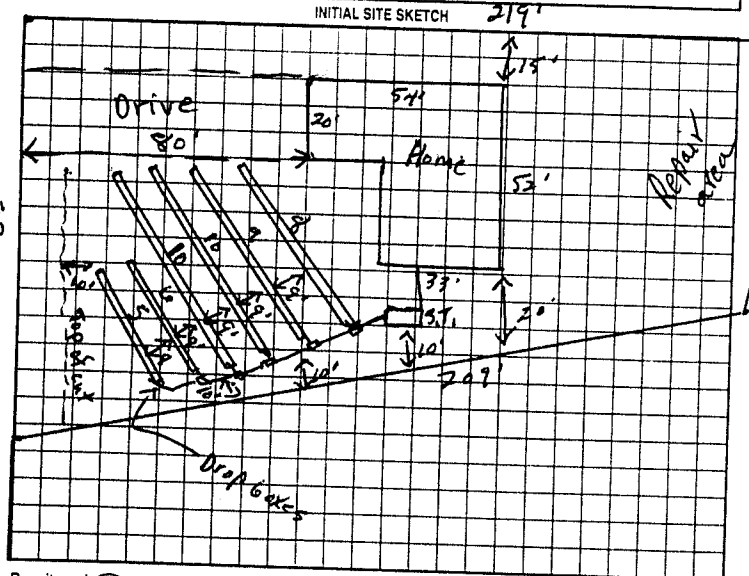

AS BUILT SKETCH

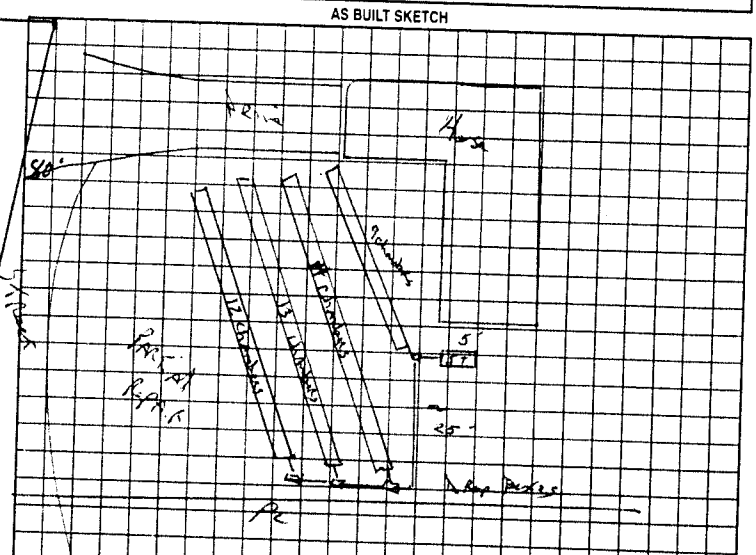

Permit can be suspended or revoked if any false information is supplied toward securing the permit/any unauthorized changes are made to the site/any unauthorized changes are made in the installation of the system. Improvement Permit with plan valid without expiration. Improvement Permit with site plan valid for sixty months. Authorization to Construct is valid for a period equal to that of Improvement Permit – not to exceed sixty months.

Signed: [signature] date 2-8-00

Improvement Permit by: P.C. Moore date 2-4-00

Authorization to Construct by: P.C. Moore date 2-4-00

Installed by: C & W. Grading

Operation Permit by: [signature] date May 8 2000

Existing System Inspection by: date

HEALTH DEPT. COPY: WHITE OWNER COPY (FINAL): YELLOW OWNER COPY (INITIAL): PINK