IREDELL COUNTY HEALTH DEPARTMENT

STATESVILLE 704-878-5305 MOORESVILLE 704-664-5281

IMPROVEMENT PERMIT / AUTHORIZATION TO CONSTRUCT / OPERATION PERMIT / EXISTING SYSTEM INSPECTION

PERMIT# 76197 PIN# 4712 86 6792 DATE 9-9-98

OWNER OR CONTRACTOR Collier Properties PHONE: Business 704 924 7120 Home

ADDRESS PO Box 5806 Statesville, N.C.

LOCATION Bethlehem Rd on left, Past Air Port To Greenwich 1/8 mi left

SUBDIVISION Landings BLOCK / SECTION LOT 39 LOT AREA .5 acres SITE CLASS. PS DESIGN FLOW 360 L.T.A.R. .3

Septic Tank: 1000 Gallons; STB 825 Date 9-4-98

Pump Tank: Gallons; PT Date

Pump Make: Model Serial No.

Nitrification Field: No Fields 1 Square Feet 900 Linear Feet 300

No Lines 4 Trench Width 36" Max Trench Bottom Depth 36" Gravel Depth N/A

☑ New System ☐ Repair System Type: I, II, III, IV, V, VI

System Description: Gravity/ 25% Reduction

Repair System Description: Pump to 25% Red.

Maintenance Agreement Required: ☐ Yes ☑ No

☐ House/Mod. Home No. Bedrooms 3

☐ Mobile Home No. Bathrooms 2

☐ Business No. Employees

☐ Other

☐ Slab ☑ Crawl Space ☐ Basement w/plumbing ☐ Basement wo/plumbing


Water Supply: ☐ Individual ☑ Public ☐ Community

Comments:/Conditions:


Comments:/Conditions:

KEEP ALL VEHICULAR TRAFFIC OFF OF DRAINFIELD; DRIVEWAY TO BE INSTALLED AS SHOWN

INITIAL SITE SKETCH

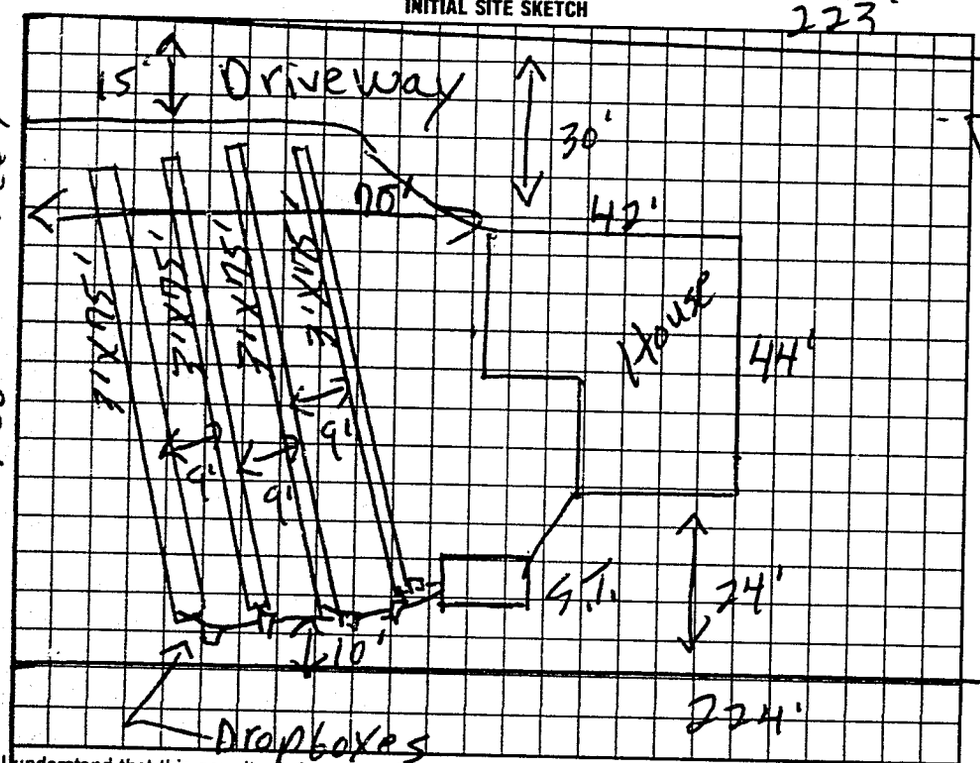

AS BUILT SKETCH

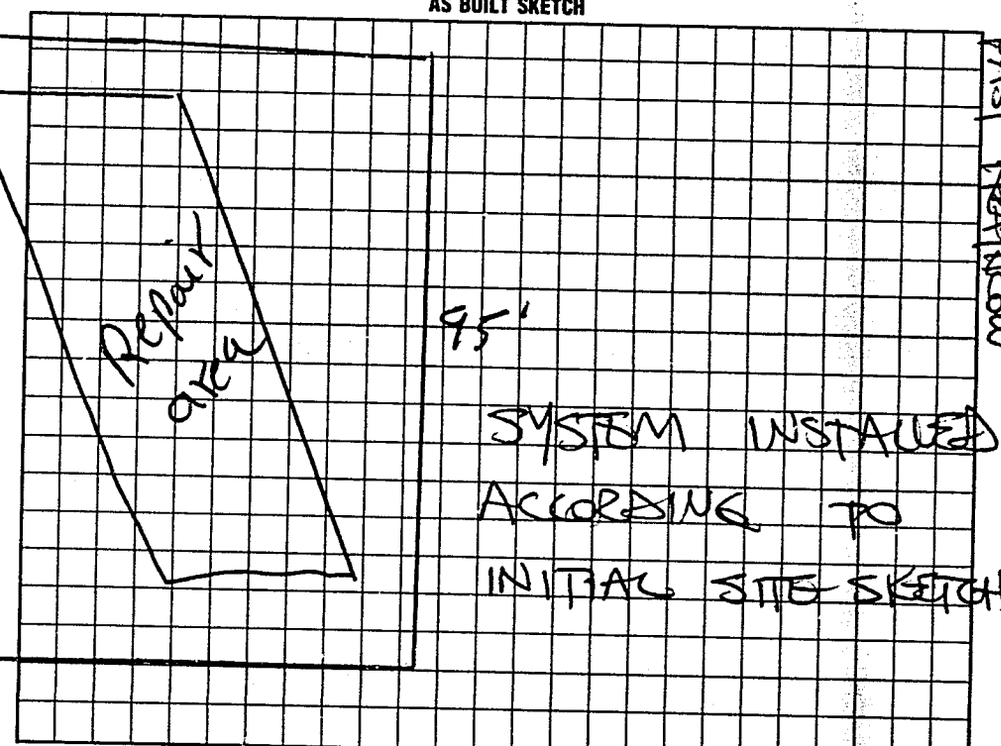

I understand that this permit can be suspended or revoked if any false information is supplied toward securing the permit/any unauthorized changes are made to the site/any unauthorized changes are made in the installation of the system. Improvement Permit with plat valid without expiration. Improvement Permit with site plan valid for sixty months. Authorization to Construct is valid for a period equal to that of Improvement Permit – not to exceed sixty months.

Signed: Robert A Collier IV date 9-11-98

Improvement Permit by: R. C. Moore date 9-9-98

Authorization to Construct by: R. C. Moore date 9-9-98

Installed by: C & W GRADING

Operation Permit by: STEVE HEDRICK date 12-1-98

Existing System Inspection by: date

HEALTH DEPT. COPY: WHITE INSPECTION COPY (FINAL): GREEN OWNER COPY (FINAL): YELLOW INSPECTION COPY (INITIAL): PINK OWNER COPY (INITIAL): GOLD