IREDELL COUNTY HEALTH DEPARTMENT

STATESVILLE 704-878-5305 MOORESVILLE 704-664-5281

IMPROVEMENT PERMIT / AUTHORIZATION TO CONSTRUCT / OPERATION PERMIT / EXISTING SYSTEM INSPECTION

PERMIT# 80594 PIN# 4713 86 67 92

OWNER OR CONTRACTOR Collier Properties PHONE: Business 924 7120 Home DATE 4 23 99

ADDRESS Po Box 366 Statesville NC

LOCATION Hwy 70 W (L) Bethlehem 1.25 mile (L) Greenwich on Left

SUBDIVISION The Landings BLOCK / SECTION LOT 43 LOT AREA .64 SITE CLASS PS DESIGN FLOW 360 L.T.A.R. .3

Septic Tank: 1000 Gallons; STB 1012 Date 4 7 99

Pump Tank: Gallons; PT Date

Pump Make: Model Serial No

Nitrification Field: No Fields 1 Square Feet 1200 Linear Feet 400

No Lines 4 Trench Width 36" Max Trench Bottom Depth 36" Gravel Depth 12"

(X) New System ( ) Repair System Type: I (II) III IV V VI

System Description: Conv GRAVITY

Repair System Description: @ 25% Reduction GRAVITY

Maintenance Agreement Required: ( ) Yes (X) No

(X) House/Mod. Home No. Bedrooms 3

( ) Mobile Home No. Bathrooms 2

( ) Business No. Employees

( ) Other


( ) Slab (X) Crawl Space ( ) Basement w/plumbing ( ) Basement wo/plumbing

Water Supply: (X) Individual ( ) Public ( ) Community


Comments/Conditions:

Comments/Conditions

INITIAL SITE SKETCH

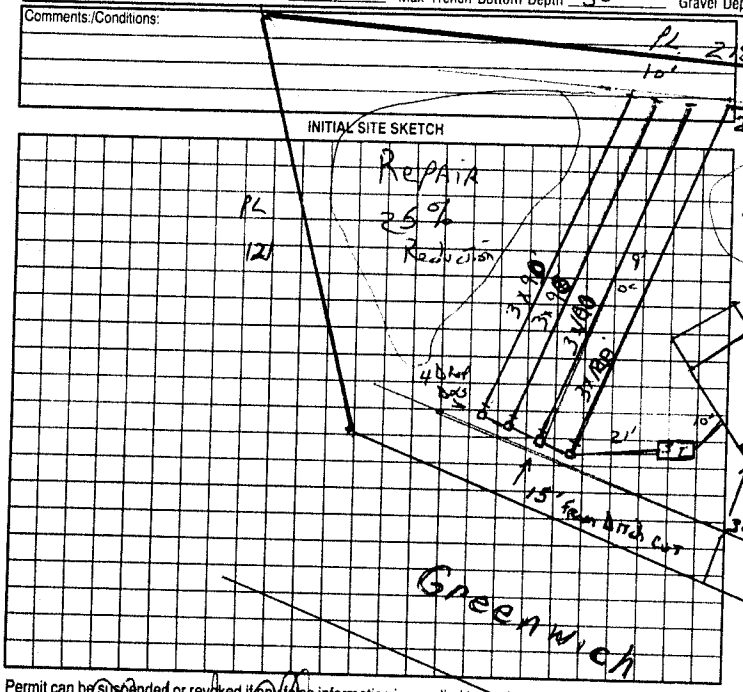

AS BUILT SKETCH

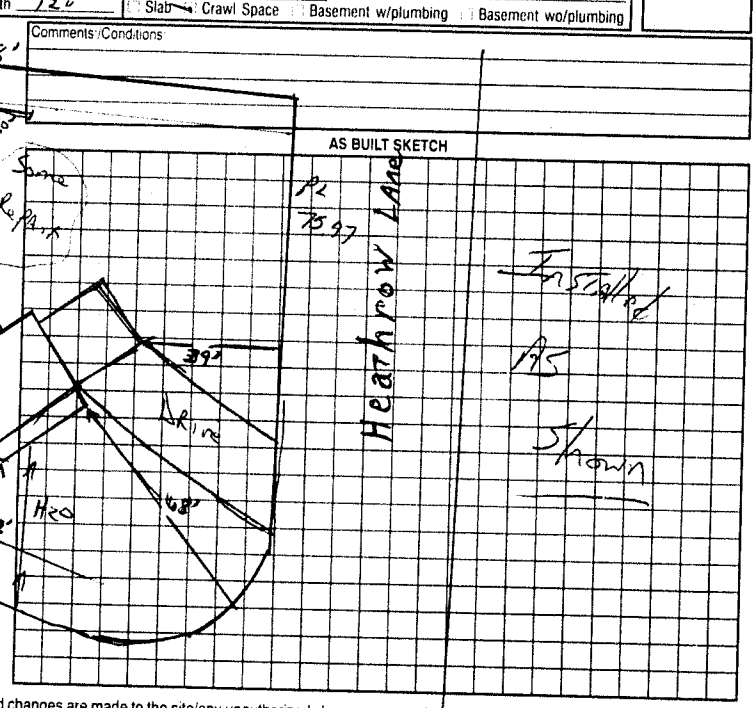

Permit can be suspended or revoked if any false information is supplied toward securing the permit/any unauthorized changes are made to the site/any unauthorized changes are made in the installation of the system. Improvement Permit with plat valid without expiration. Improvement Permit with site plan valid for sixty months. Authorization to Construct is valid for a period equal to that of Improvement Permit - not to exceed sixty months.

Signed: date 4-23-99 Installed by: C & W Grading

Improvement Permit by: C Potter date 4.23.99 Operation Permit by: C Potter date 6/1/99

Authorization to Construct by: C Potter date 4-23-99 Existing System Inspection by: date

HEALTH DEPT COPY WHITE OWNER COPY (FINAL) YELLOW OWNER COPY (INITIAL) PINK